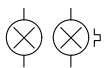
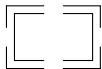
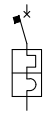
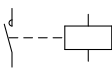
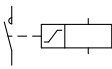
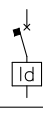
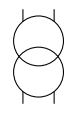
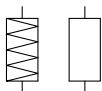


|                                                                                                                                                                                                                                                               |            |---------------------------------------------------------------------------------------------------------------------------------------------------------------------------------------------------------------------------------------------------------------|------------|-----------------------------------------------------------------------------------------------------------------------|---------------------------|----------------------|---------------------------|---|------------------------------------------------------------------------------------------------------|-----------------------|-----------------|----|----------|--------|----|-------------------|----|----|----|-------------------|----|---------|--|
| 1                                                                                                                                                                                                                                                             | 2          | 3                                                                                                                     | 4                         | 5                    | 6                         | 7 | 8                                                                                                    | 9                     | 10              | 11 | 12       | 13     | 14 | 15                | 16 | 17 | 18 | 19                | 20 |         |  |
| TENDRARA PROJECT<br>GAS TREATMENT AND LNG PRODUCTION PLANT<br>ON RENTAL BASIS                                                                                                                                                                                 |            |                                                                                                                       | SAFETY CRITICAL ELEMENT LIST                                                                                                                                                                                                                                  |            |                                                                                                                       |                                                                                                                                                                                                                                                               |            |                                                                                                                                                                                                                                                               |            | IFI                                                                                                                                                                                                                                                           | 2          | 11/04/2025                                                                                                            | AS-BUILT                  |                      |                           |   | ADF                                                                                                  | GDP                   | IC              |    |          |        |    |                   |    |    |    |                   |    |         |  |
| IFI                                                                                                                                                                                                                                                           | 1          | 31/03/2025                                                                                                            | GENEERAL REVIEW           |                      |                           |   | ADF                                                                                                  | GDP                   | IC              |    |          |        |    |                   |    |    |    |                   |    |         |  |
| IFI                                                                                                                                                                                                                                                           | 0          | 26/03/2024                                                                                                            | ISSUED FOR COMMENTs       |                      |                           |   | ADF                                                                                                  | GDP                   | IC              |    |          |        |    |                   |    |    |    |                   |    |         |  |
| Status                                                                                                                                                                                                                                                        | Rev. n.    | Rev. n.                                                                                                               | Rev. n.                   |                      |                           |   | Rev. n.                                                                                              | Rev. n.               | Rev. n.         |    |          |        |    |                   |    |    |    |                   |    |         |  |
|                                                                                                                                                                                                                                                               | Rev. Index | Date                                                                                                                  | Description               |                      |                           |   | Prepared                                                                                             | Checked               | Approved        |    |          |        |    |                   |    |    |    |                   |    |         |  |
| Client                                                                                                                                                                                                                                                        |            |                                                                                                                       |                           |                      |                           |   | Project Title                                                                                        |                       |                 |    |          |        |    |                   |    |    |    |                   |    |         |  |
| <div><div><div><div></div><div>ManaEnergy</div><div>Managem Group</div></div><div><div>MANAENERGY</div><div>Mahaj Riad Center, Batiment 6, 3eme etage</div><div>Avenue Al Arz, Hay Ryad, 10100 Rabat, Morocco</div></div></div></div>                         |            |                                                                                                                       |                           |                      |                           |   | TENDRARA PROJECT                                                                                     |                       |                 |    |          |        |    |                   |    |    |    |                   |    |         |  |
| Contractor                                                                                                                                                                                                                                                    |            |                                                                                                                       |                           |                      |                           |   | Provision of a m-LNG plant<br>for production for ManaEnergy                                          |                       |                 |    |          |        |    |                   |    |    |    |                   |    |         |  |
| <div><div><div><div></div><div>ITALFLUID</div></div><div><div>ITALFLUID GEOENERGY</div><div>Marocco Branch</div><div>Boulevard de Bourgogne Rue Jaafar Ibn</div><div>Habib Residence Al Mashrik II 1ere Etage N3</div><div>Casablanca</div></div></div></div> |            |                                                                                                                       | Engineering                                                                                                                                                                                                                                                   |            |                                                                                                                       | <div><div><div><div></div><div>ITALFLUID</div></div><div><div>ITALFLUID GEOENERGY</div><div>Via Antonio Vivaldi, 4 Montesilvano (PE)</div><div>Tel:085-4224374 / fax: 085-4220742</div></div></div></div>                                                     |            |                                                                                                                       | Facility Name                                                                                                                                                                                                                                                 |            |                                                                                                                       | Location                  |                      |                           |   | Scale                                                                                                |                       | Sheet of Sheets |    |          |        |    |                   |    |    |    |                   |    |         |  |
| TENDRARA                                                                                                                                                                                                                                                      |            |                                                                                                                       | MOROCCO                   |                      |                           |   | A4                                                                                                   |                       | 1 of 26         |    |          |        |    |                   |    |    |    |                   |    |         |  |
| Document Title                                                                                                                                                                                                                                                |            |                                                                                                                       |                           |                      | Doc. Code                 |   |                                                                                                      |                       |                 |    |          |        |    |                   |    |    |    |                   |    |         |  |
| P-PN-S222A.1                                                                                                                                                                                                                                                  |            |                                                                                                                       |                           |                      | ELD01-ING-FR01            |   |                                                                                                      |                       |                 |    |          |        |    |                   |    |    |    |                   |    |         |  |
| LNG PUMP SKID S-222A                                                                                                                                                                                                                                          |            |                                                                                                                       |                           |                      | Vendor Doc. code          |   |                                                                                                      |                       |                 |    |          |        |    |                   |    |    |    |                   |    |         |  |
|                                                                                                                                                                                                                                                               |            |                                                                                                                       |                           |                      | IE24090_SE02_P-PN-S222A.1 |   |                                                                                                      |                       |                 |    |          |        |    |                   |    |    |    |                   |    |         |  |
|                                                                                                                                                                                                                                                               |            |                                                                                                                       | Project :<br>P–PN–S222A.1 |                      |                           |   | Customer : <div><div><div><div></div><div>ManaEnergy</div><div>Managem Group</div></div></div></div> |                       |                 |    | Object : |        |    |                   |    |    |    |                   |    |         |  |
| General Contractor :                                                                                                                                                                                                                                          |            | Manufacture : <div><div><div><div></div><div>esa</div><div></div></div><div>esaelettromeccanica.com</div></div></div> |                           | LNG PUMP SKID S–222A |                           |   |                                                                                                      | Contract :<br>IE24090 |                 |    |          | Rev. 2 |    | Data : 11/04/2025 |    |    |    | Date : 26/03/2024 |    |         |  |
|                                                                                                                                                                                                                                                               |            |                                                                                                                       |                           |                      |                           |   |                                                                                                      | S/N :<br>IE24090_SE02 |                 |    |          | Rev. 1 |    | Data : 31/03/2025 |    |    |    | Sheet : 1         |    | of : 26 |  |

CIRCUIT SYMBOLS ACCORDING TO CEI STANDARD

|                                                                                     |                                                                                                                            |                                                                                     |                                                                             |                                                                                       |                                                                                       |                                                                                       |                             |
|-------------------------------------------------------------------------------------|----------------------------------------------------------------------------------------------------------------------------|-------------------------------------------------------------------------------------|-----------------------------------------------------------------------------|---------------------------------------------------------------------------------------|---------------------------------------------------------------------------------------|---------------------------------------------------------------------------------------|-----------------------------|
|    | ISOLATOR                                                                                                                   |    | ELECTRONIC TIMER<br>WITH PICK-UP DELAY                                      |    | MUSHROOM PUSH-BUTTON PULSE CONTACT WITH<br>STAY-PUT MAKE CONTACT OPERATED BY STRIKING |    | STEDY OR FLASHING LIGHT     |
|    | FUSED ISOLATOR                                                                                                             |    | ELECTRIC PULSE METER                                                        |    | KEY OPERATING DEVICE FOR SELECTORS,<br>PUSH-BUTTON, ETC.                              |    | PLC UNIT                    |
|    | CIRCUIT BREAKER WITH THERMAL AED MAGNETIC<br>OVERCURRENT RELEASES                                                          |    | FUSE CARRIER                                                                |    | PRESSURE SWITCH                                                                       |    | CONTROL INSTRUMENT          |
|    | CIRCUIT BREAKER WITH MAGNETIC RELEASE                                                                                      |    | MAKE CONTACT OF CONTACTOR                                                   |    | TEMPERATURE SWITCH                                                                    |    | ENERGY METER                |
|    | CIRCUIT BREAKER WITH THERMAL, MAGNETIC<br>AND DIFFERENTIAL RELEASES                                                        |    | MAKE CONTACT OF CONTACTOR                                                   |    | FLOW SWITCH                                                                           |    | MEASURING INSTRUMENT        |
|    | RESIDUAL CURRENT CIRCUIT BREAKER<br>"AC" TYPE FOR ALTERNATING CURRENT<br>"A" TYPE FOR ALTERNATING OR PULSATING<br>CURRENTS |    | MAKE AND BREAK CONTACT                                                      |    | FLOAT SWITCH                                                                          |    | VOLTAGE TRANSFORMER         |
|    | THERMAL RELAY (OVERLOAD RELAY)                                                                                             |    | MAKE AND BREAK CONTACT<br>WITH DROP-OUT DELAY                               |    | BUCHHOLZ RELAY                                                                        |    | CURRENT TRANSFORMER         |
|   | COIL OF CONTACTOR RELAY                                                                                                    |   | MAKE AND BREAK CONTACT<br>WITH PICK-UP DELAY                                |   | CAM OPERATED DEVICE                                                                   |   | ACOUSTIC SIGNALLING DEVICE  |
|  | COIL OF SHUT-OFF<br>ALARM MAKE CONTACT ON ENERGIZATION                                                                     |  | MAKE AND BREAK CONTACT<br>WITH DROP-OUT AND PICK-UP DELAY<br>(FLIP-FLOP)    |  | PROXIMITY SWITCH                                                                      |  | RESISTANCE                  |
|  | COIL OF SHUT-OFF<br>ALARM DENERGIZES IN CASE OF UNDERVOLTAGE                                                               |  | MAKE AND BREAK CONTACT<br>OF THERMAL RELAY                                  |  | TEMPERATURE SENSOR                                                                    |  | CAPACITOR                   |
|   | COIL OF OPERATING DEVICE<br>WITH DROP-OUT DELAY                                                                            |  | MAKE AND BREAK CONTACT<br>OF LIMIT SWITCH                                   |  | PHOTOELECTRIC SENSOR                                                                  |  | SINGLE-PHASE ELECTRIC MOTOR |
|   | COIL OF OPERATING DEVICE<br>WITH PICK-UP DELAY                                                                             |  | MULTI POSITION SWITCH<br>(GENERAL SYMBOL)                                   |  | SOLENOID VALVE                                                                        |  | THREE-PHASE ELECTRIC MOTOR  |
|   | COIL OF OPERATING DEVICE<br>WITH DROP-OUT AND PICK-UP DELAYS                                                               |  | MAKE AND BREAK CONTACT OPERATED<br>BY TURNING WITH SPRING RETURN            |  | PHOTOCELL                                                                             |                                                                                       |                             |
|   | COIL OF LATCHING RELAY<br>(STEP-BY-STEP FUNCTION)                                                                          |  | MAKE AND BREAK CONTACT OPERATED<br>BY PUSHING WITH SPRING RETURN            |                                                                                       |                                                                                       |                                                                                       |                             |
|  | ELECTRONIC OR ELECTRO-MECHANICAL<br>TIME SWITCH                                                                            |  | MAKE AND BREAK CONTACT OPERATED<br>BY PULLING WITH OR WITHUOT SPRING RETURN |                                                                                       |                                                                                       |                                                                                       |                             |


CONDUCTOR COLOR CODING INSIDE CONTROL PANEL

|                                         |              |
|-----------------------------------------|--------------|
| AC AND DC POWER CIRCUIT                 | BLACK        |
| NEUTRAL CONDUCTOR OF POWER CIRCUIT      | LIGHT-BLUE   |
| PROTECTIVE CONDUCTOR (EARTH CONDUCTOR)  | YELLOW-GREEN |
| 110/220V AC AUXILIARY CIRCUIT (*)       | RED          |
| 24V AC AUXILIARY CIRCUIT                | WHITE        |
| 24V AC AND DC PLC INPUT                 | GRAY         |
| 24V AC PLC OUTPUT                       | WHITE        |
| 24V AC AND DC INTERLOCKING CIRCUIT      | ORANGE       |
| 24V DC AUXILIARY CIRCUIT AND PLC OUTPUT | DARK-BLUE    |


(\*) : RED FOR 110V AND BROWN FOR 220V, IN CASE BOTH VOLTAGE ARE USED

| CODE | COLOUR |
|------|--------|
| 1    | Red    |
| 2    | Blue   |
| 3    | Green  |
| 4    | Yellow |
| 5    | Purple |
| 6    | Orange |
| 7    | Pink   |
| 8    | Grey   |
| 9    | White  |
| 10   | Black  |

| COLOUR           | CODE LETTERS |
|------------------|--------------|
| BLACK            | BK           |
| BROWN            | BN           |
| RED              | RD           |
| ORANGE           | OG           |
| YELLOW           | YE           |
| GREEN            | GN           |
| BLUE             | BU           |
| GREY             | GY           |
| WHITE            | WH           |
| SILVER           | SR           |
| CLEAR            | CL           |
| GREEN AND YELLOW | GNYE         |
 
|                      |  |                                                                                                      |                                                   |                                                                                                     |          |                   |                   |         |
|----------------------|--|------------------------------------------------------------------------------------------------------|---------------------------------------------------|-----------------------------------------------------------------------------------------------------|----------|-------------------|-------------------|---------|
| General Contractor : |  | Manufacture :<br> | Project :<br>P-PN-S222A.1<br>LNG PUMP SKID S-222A | Customer :<br> | Object : |                   | By :              |         |
|                      |  |                                                                                                      |                                                   |                                                                                                     | Rev. 2   | Data : 11/04/2025 | Date : 26/03/2024 |         |
|                      |  |                                                                                                      |                                                   | Contract : IE24090                                                                                  | Rev. 1   | Data : 31/03/2025 | Sheet : 3         | of : 26 |
|                      |  |                                                                                                      |                                                   | S/N : IE24090_SE02                                                                                  |          |                   |                   |         |


|  |                              |                                 |
|--|------------------------------|---------------------------------|
|  | POWER MAIN DISCONNECT SWITCH | FEEDER ID                       |
|  | 1F+N+PE~50Hz 230V            | RATED POWER Pn-RATED VOLTAGE Vn |
|  |                              | RATED CURRENT                   |

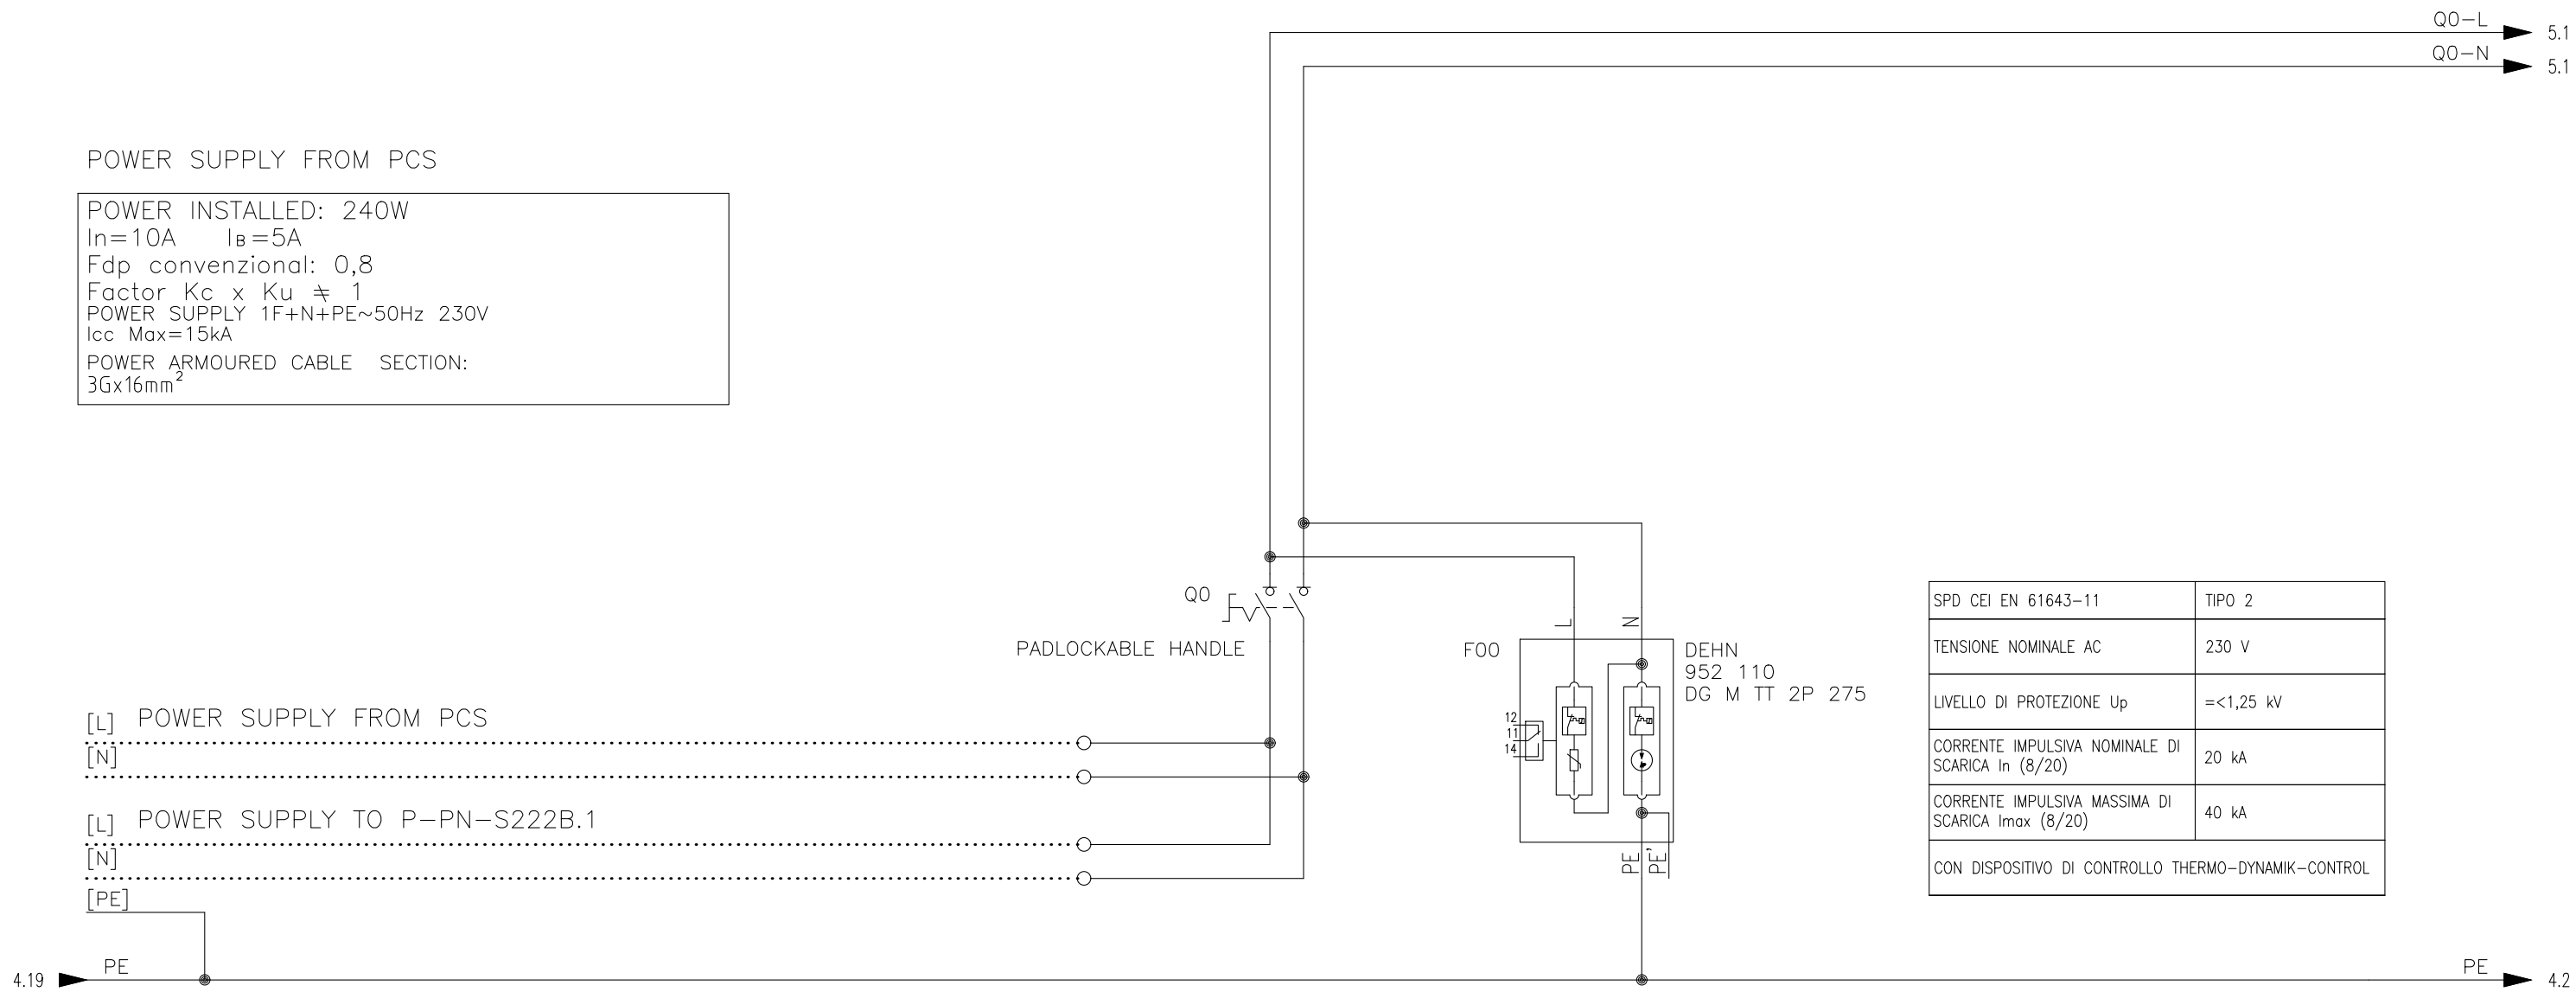

|                                                               |           |
|---------------------------------------------------------------|-----------|
| SPD CEI EN 61643-11                                           | TIPO 2    |
| TENSIONE NOMINALE AC                                          | 230 V     |
| LIVELLO DI PROTEZIONE Up                                      | =<1,25 kV |
| CORRENTE IMPULSIVA NOMINALE DI SCARICA In (8/20)              | 20 kA     |
| CORRENTE IMPULSIVA MASSIMA DI SCARICA I <sub>max</sub> (8/20) | 40 kA     |
| CON DISPOSITIVO DI CONTROLLO THERMO-DYNAMIK-CONTROL           |           |

|            |                  |                                     |
|------------|------------------|-------------------------------------|
| PROTECTION | TECHNOR PSRC-220 | TYPE                                |
|            |                  | RATED BREAKING CAPACITY Icu         |
|            | 20A              | RATED or THERMAL CURRENT In or Ith  |
|            |                  | MAGNETIC RELEASE CHARACTERISTICS Im |
|            |                  | RATED R.C. SENSITIVITY Idn          |
| CONDUCTOR  |                  | WIRE SECTION                        |
|            |                  | CABLE TYPE                          |
|            |                  | CABLE CARRYING LOAD Iz              |
|            |                  | CABLE LENGHT                        |
|            |                  | LINE ID                             |
|            |                  | WIRE ID ON TERMINAL                 |
|            |                  |                                     |

|                                                                                                                              |  |                                                   |                                                                                                     |                             |           |         |  |
|------------------------------------------------------------------------------------------------------------------------------|--|---------------------------------------------------|-----------------------------------------------------------------------------------------------------|-----------------------------|-----------|---------|--|
| General Contractor :<br>Manufacture :<br> |  | Project :<br>P-PN-S222A.1<br>LNG PUMP SKID S-222A | Customer :<br> | Object :                    |           | By :    |  |
|                                                                                                                              |  | Contract : IE24090<br>S/N : IE24090_SE02          | Rev. 2<br>Data : 11/04/2025                                                                         | Date : 26/03/2024           |           |         |  |
|                                                                                                                              |  |                                                   |                                                                                                     | Rev. 1<br>Data : 31/03/2025 | Sheet : 4 | of : 26 |  |


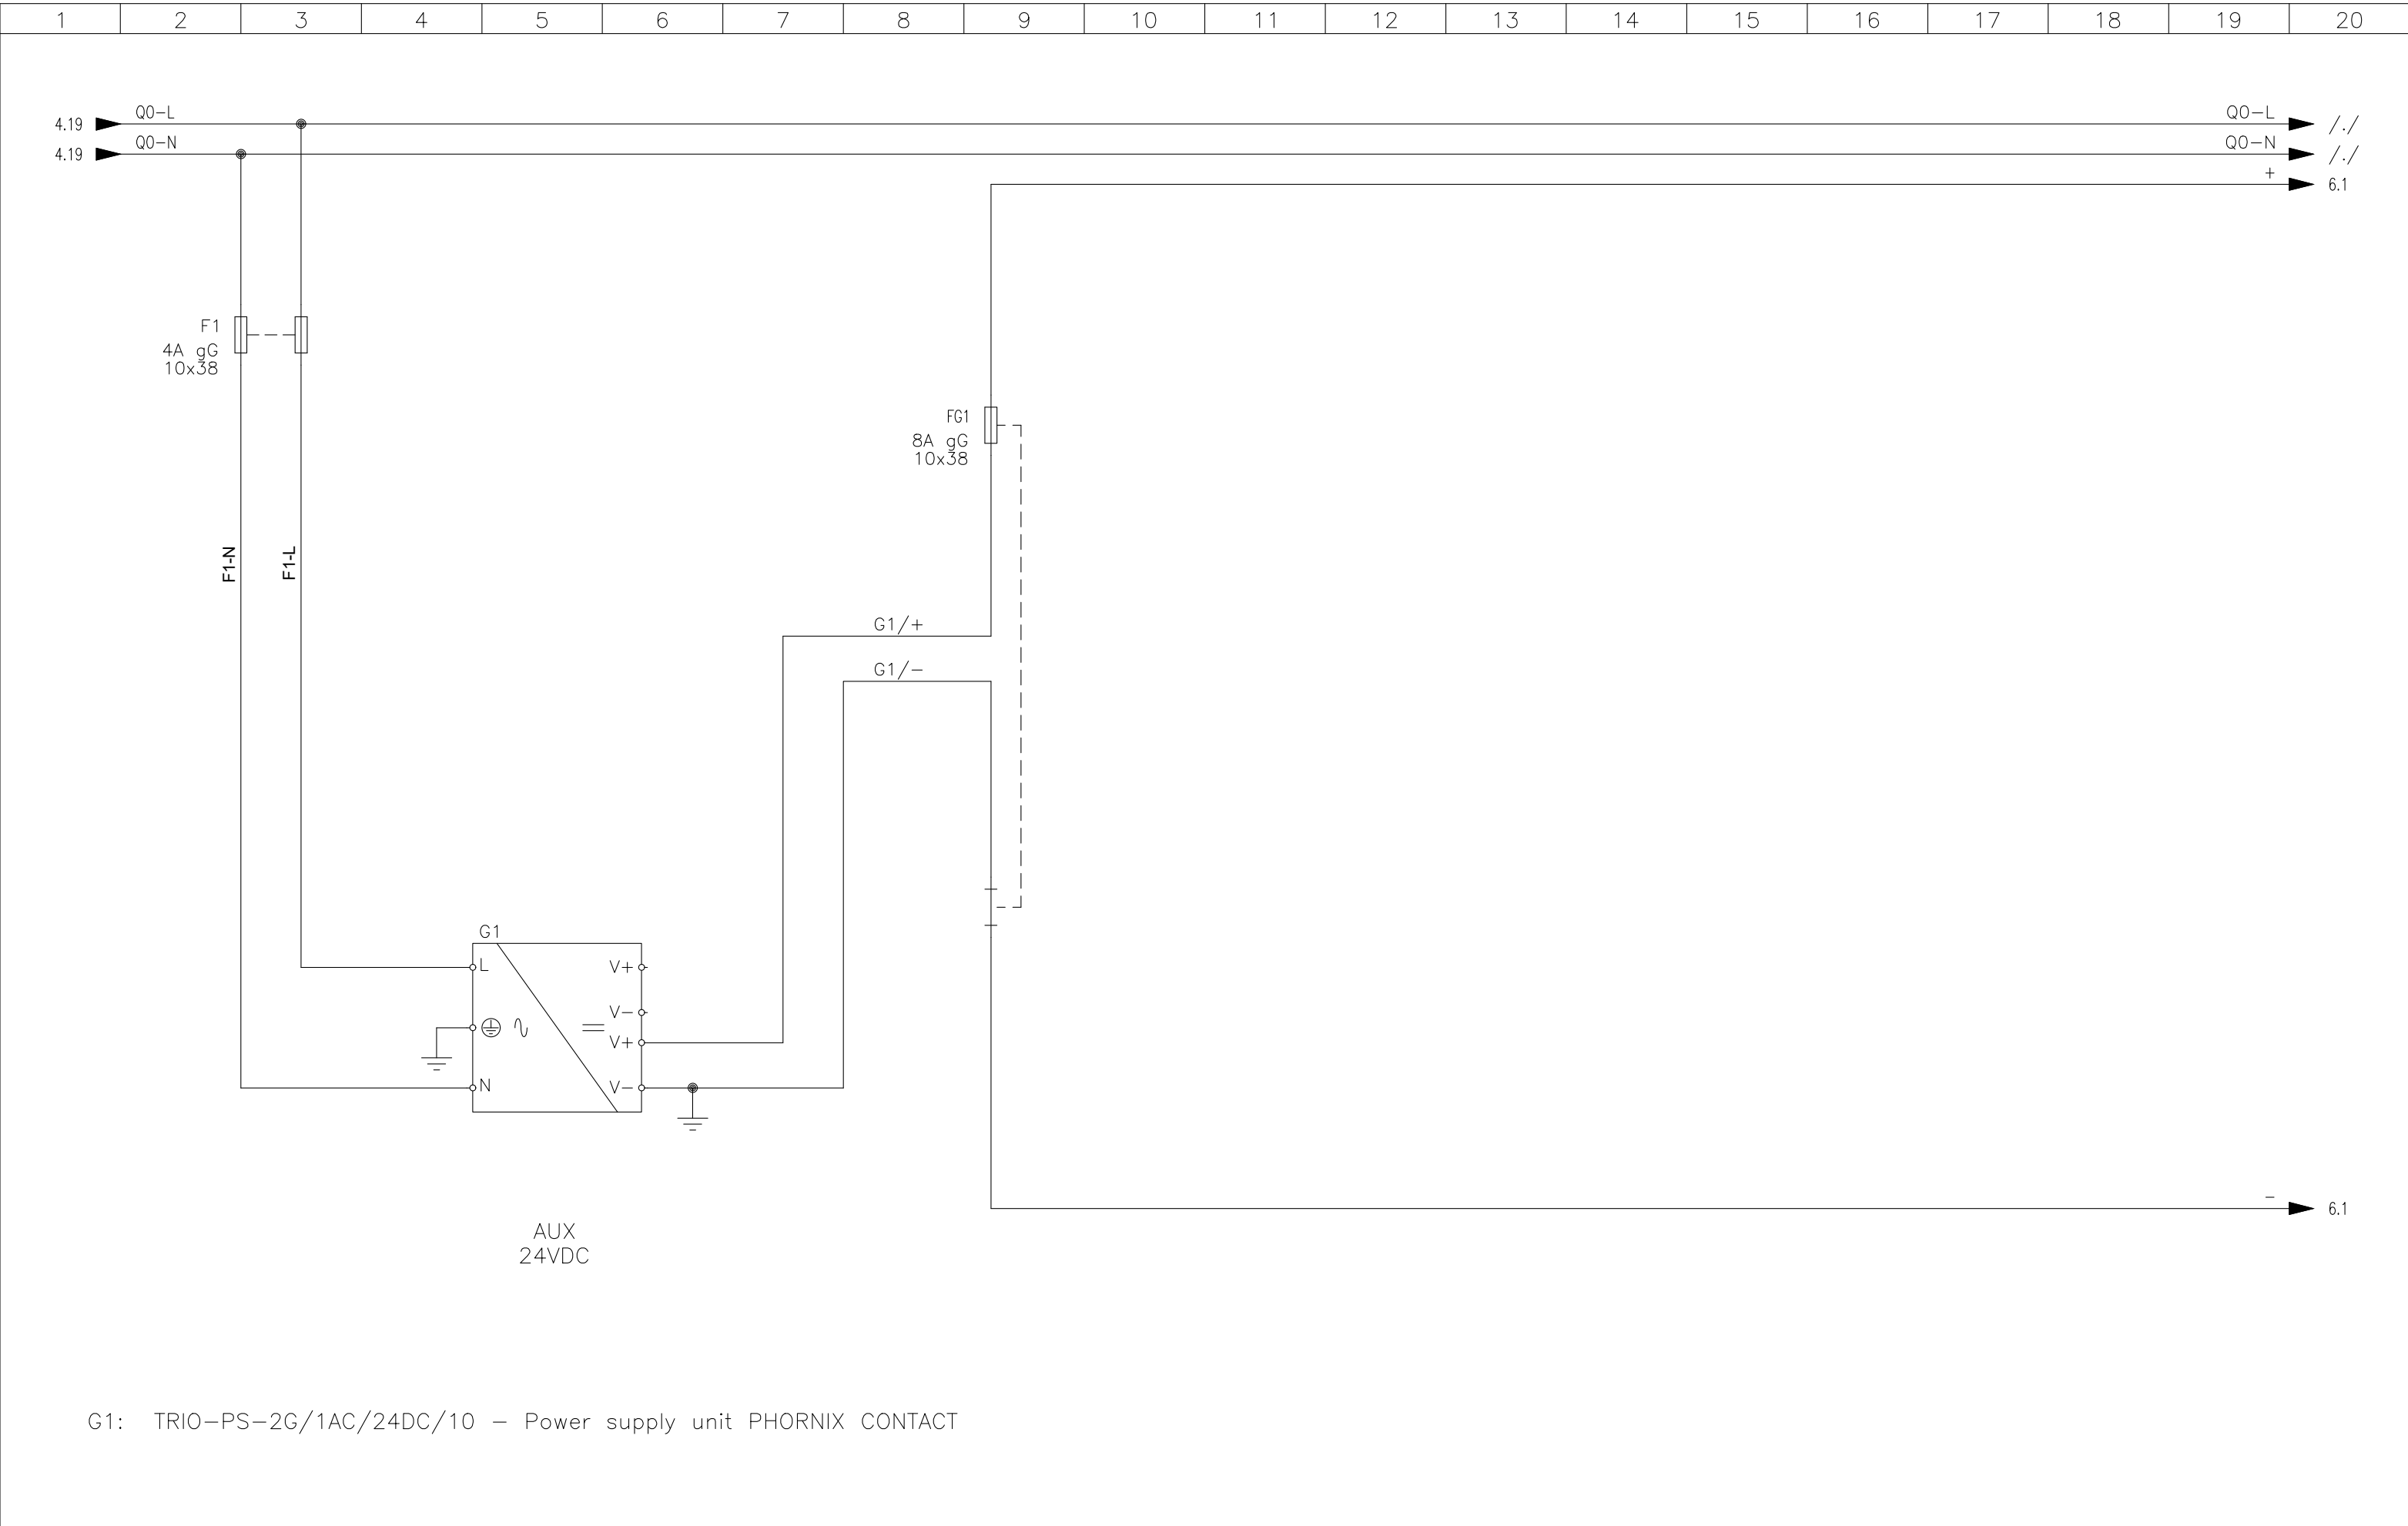


|                                                                                                                                                         |
|---------------------------------------------------------------------------------------------------------------------------------------------------------|
| <div>General Contractor :</div> <div><div>Manufacture :</div><div><div>esa</div><div></div></div><div><small>es.electrotechnica.com</small></div></div> |
|---------------------------------------------------------------------------------------------------------------------------------------------------------|











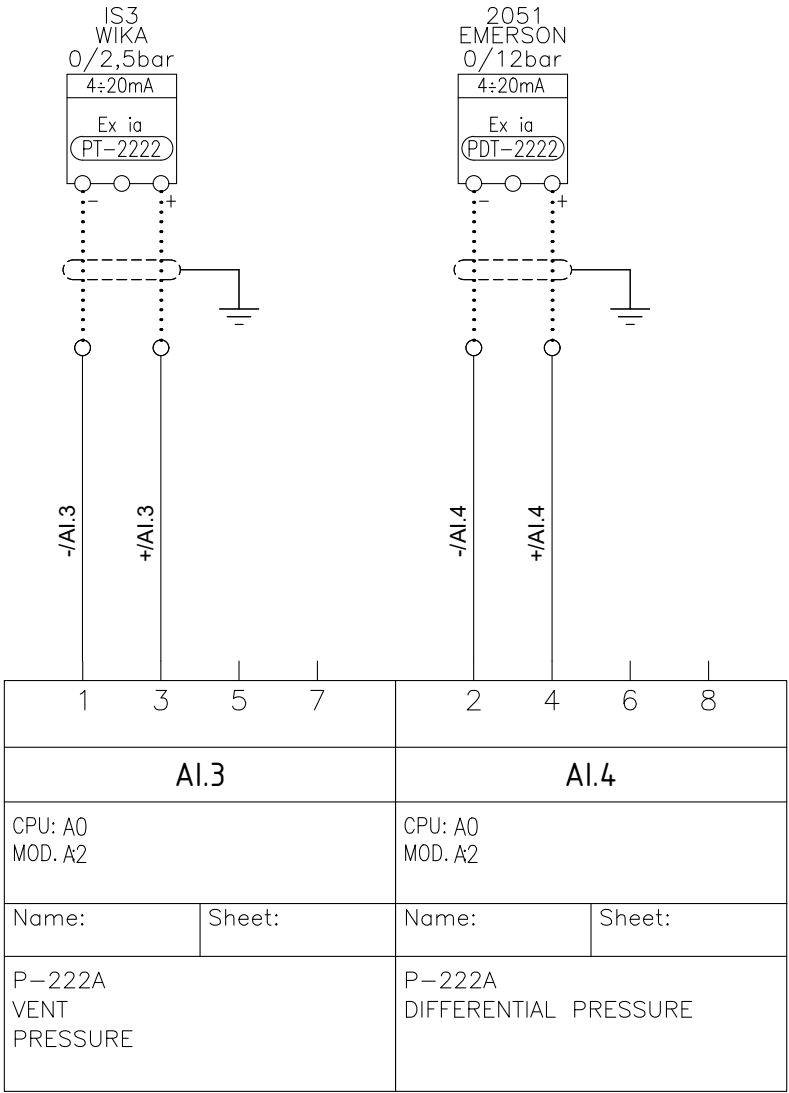
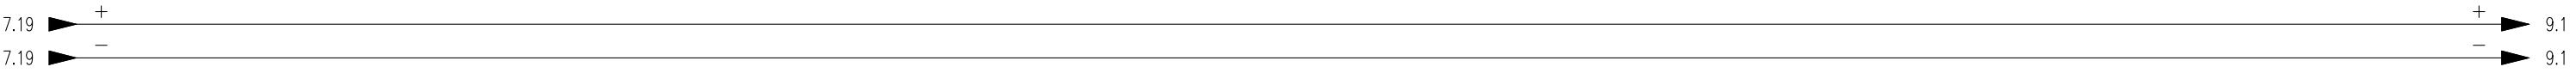










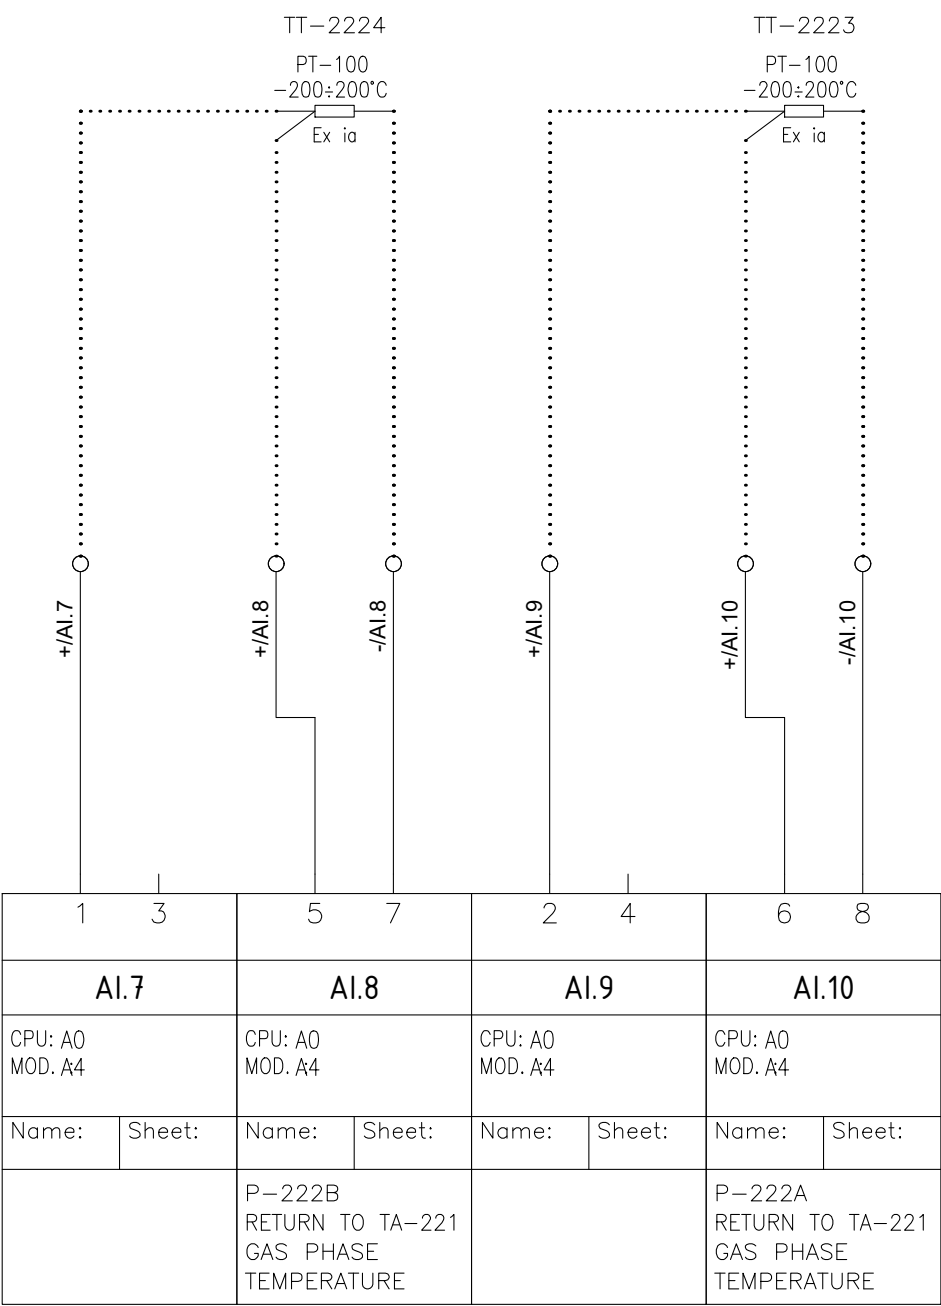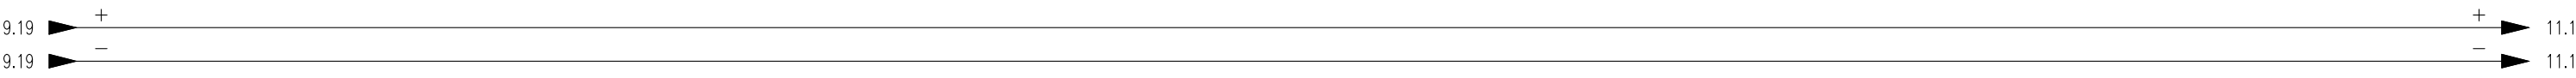

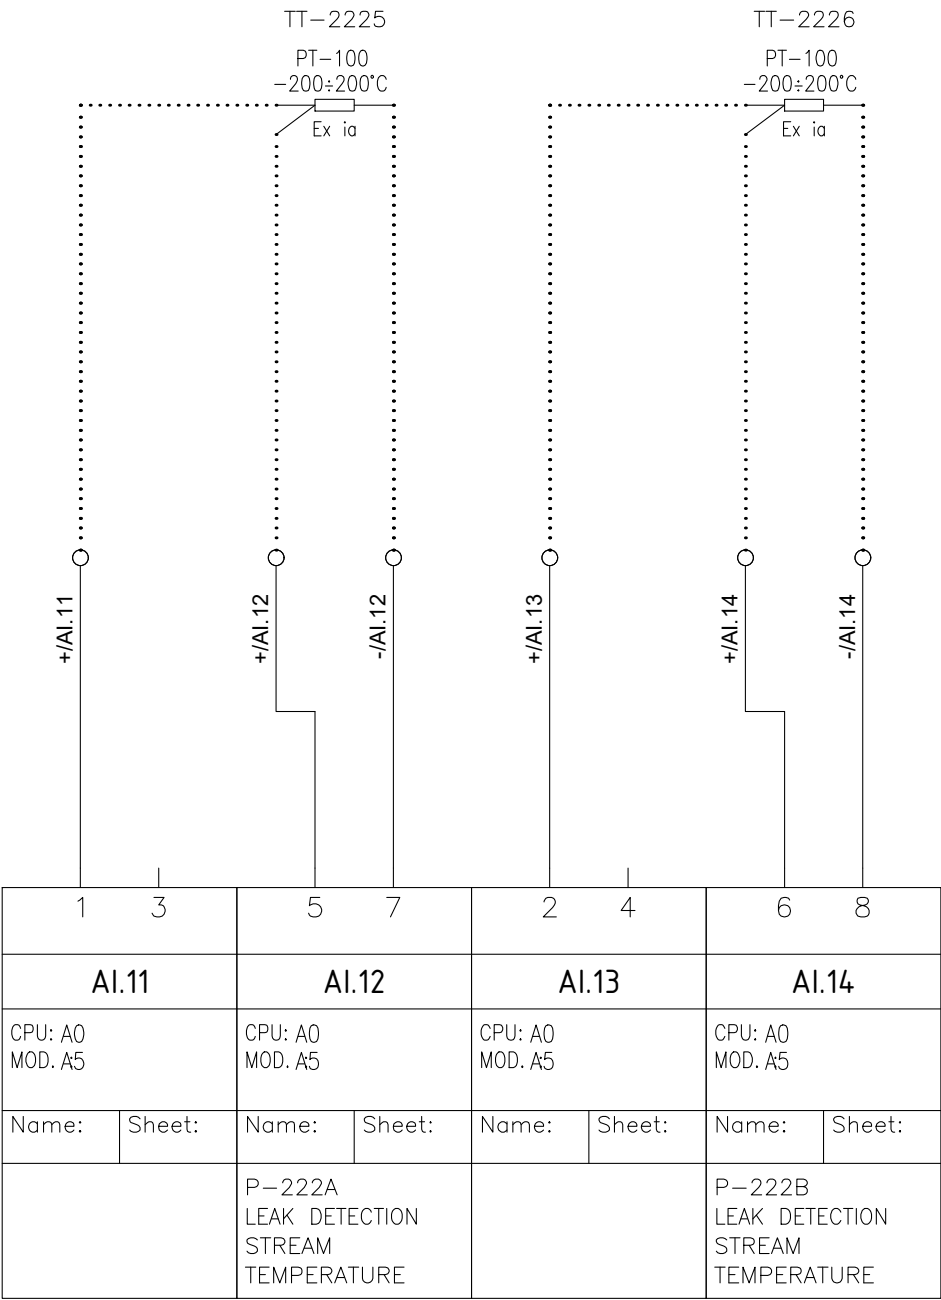
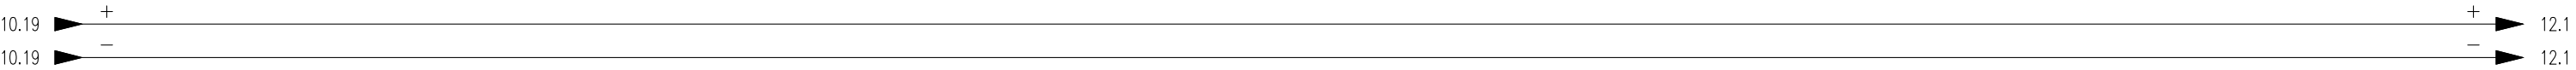


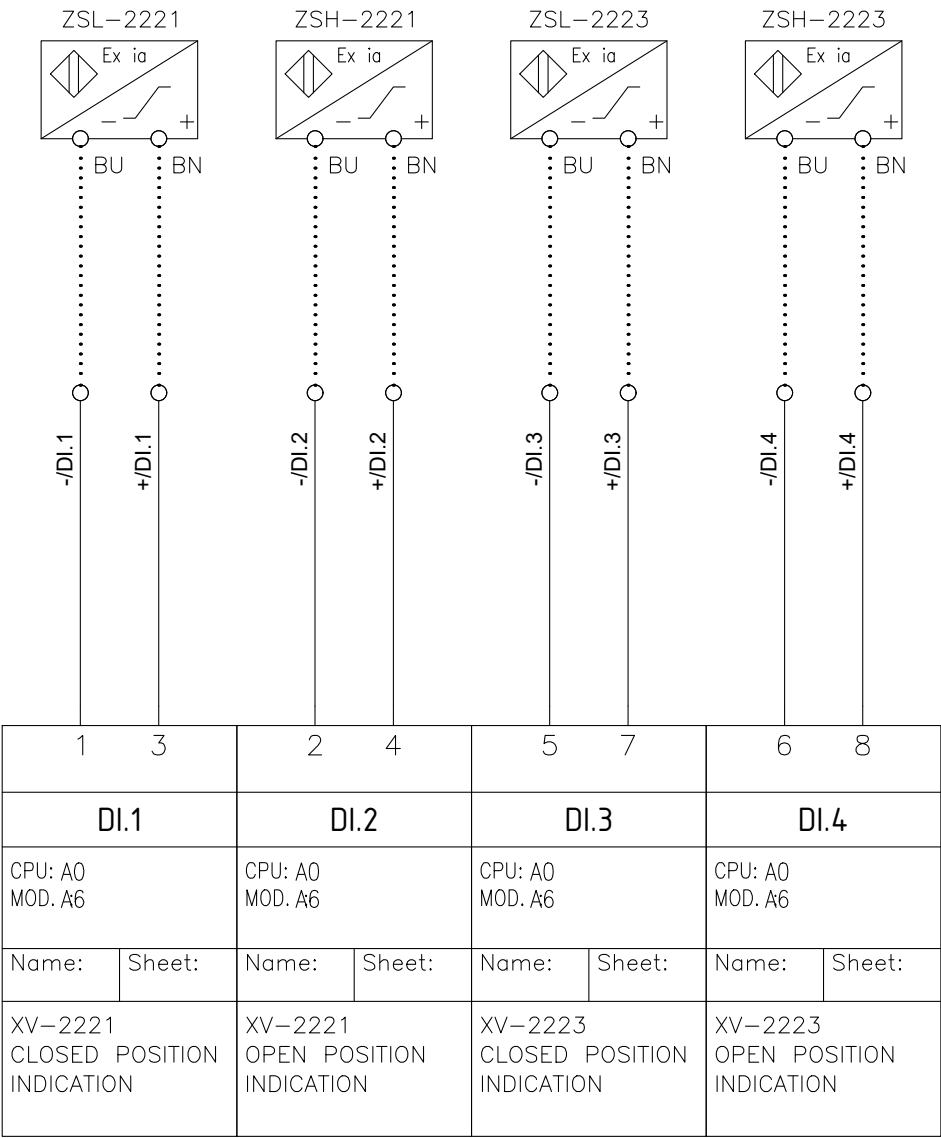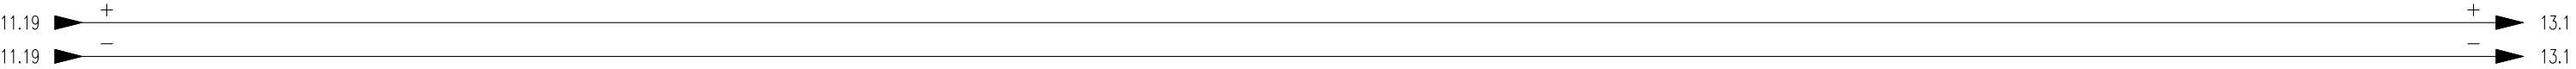


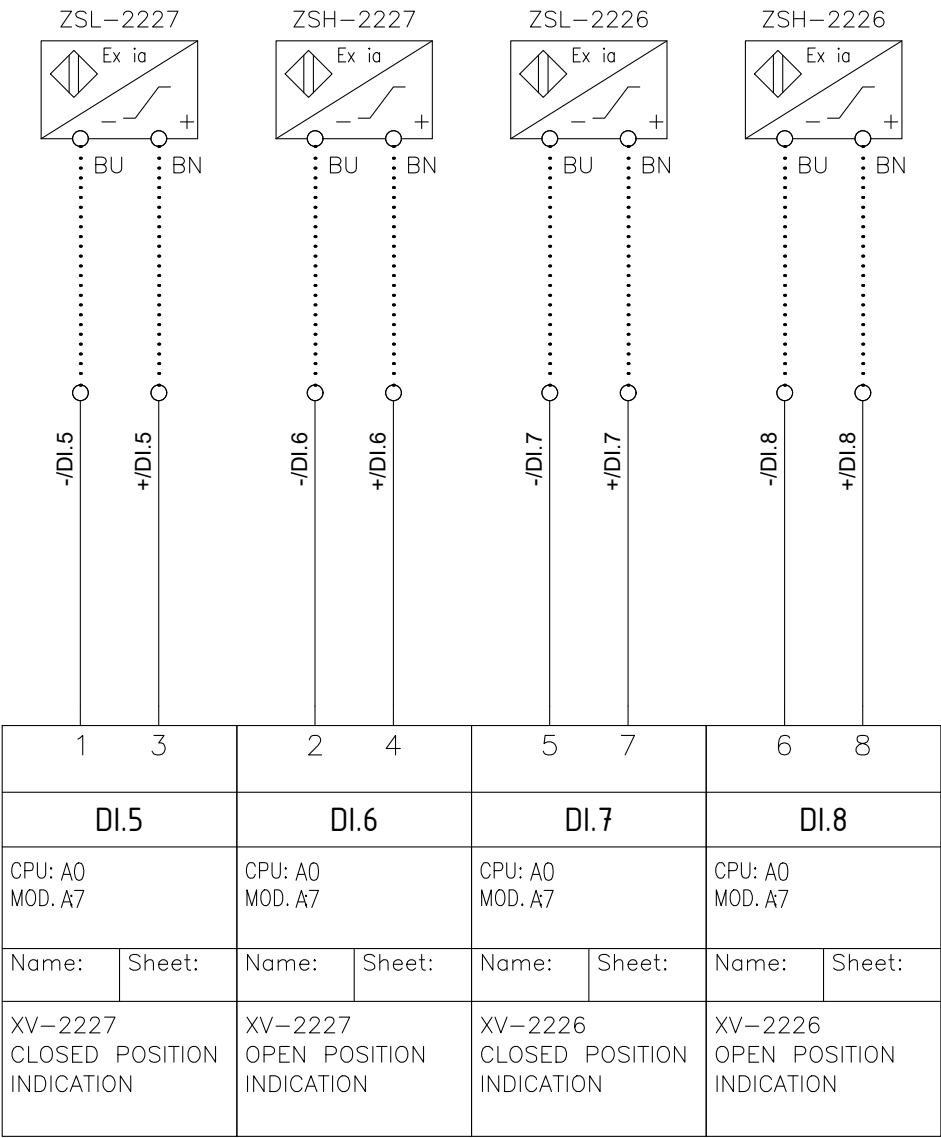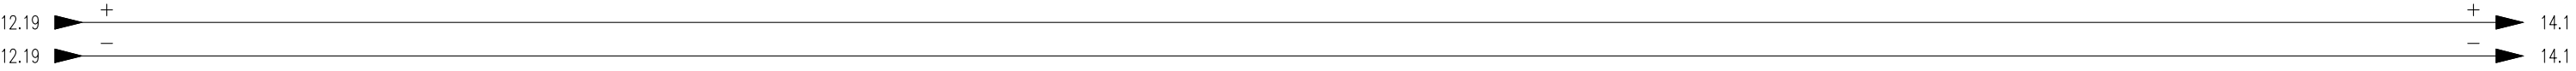

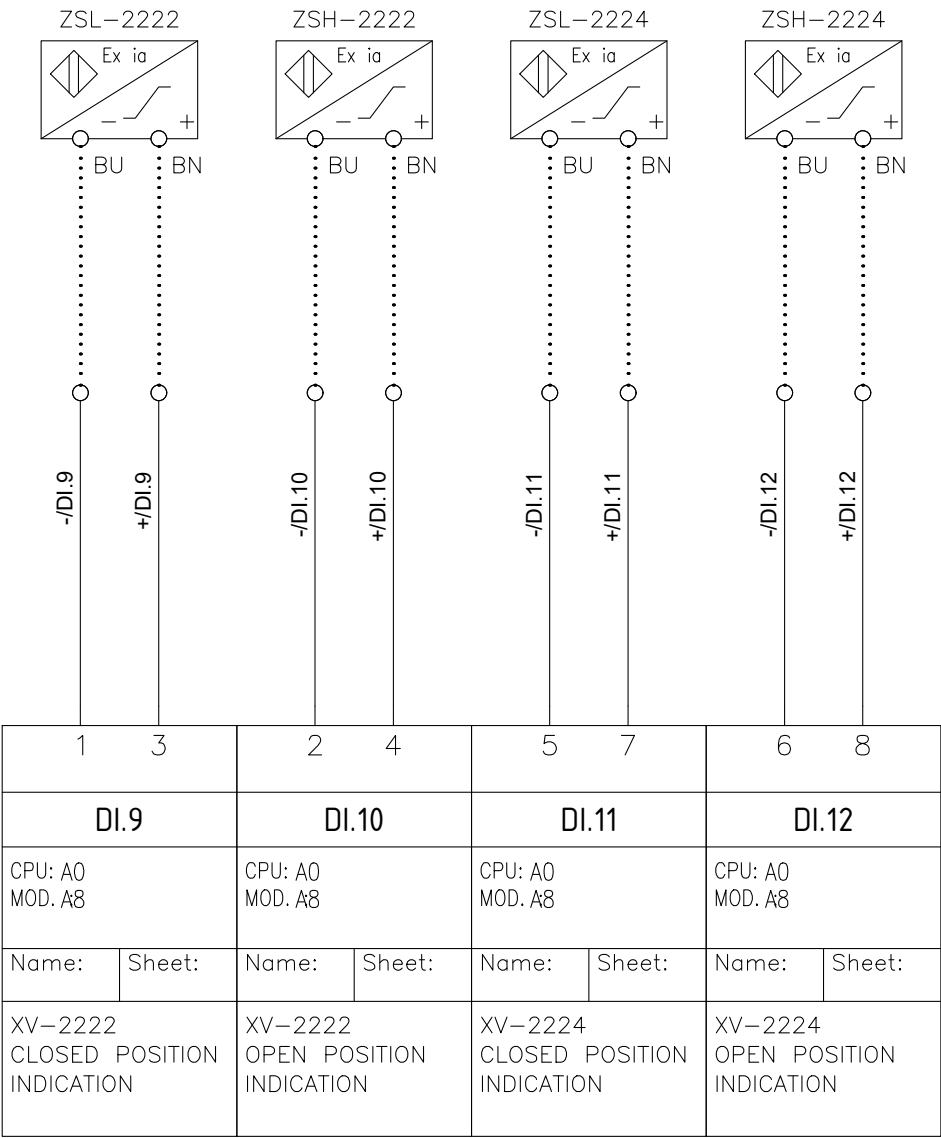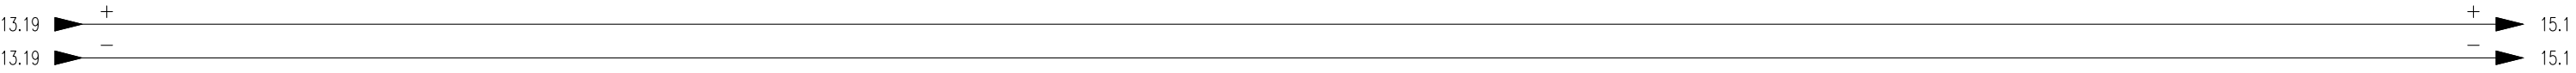





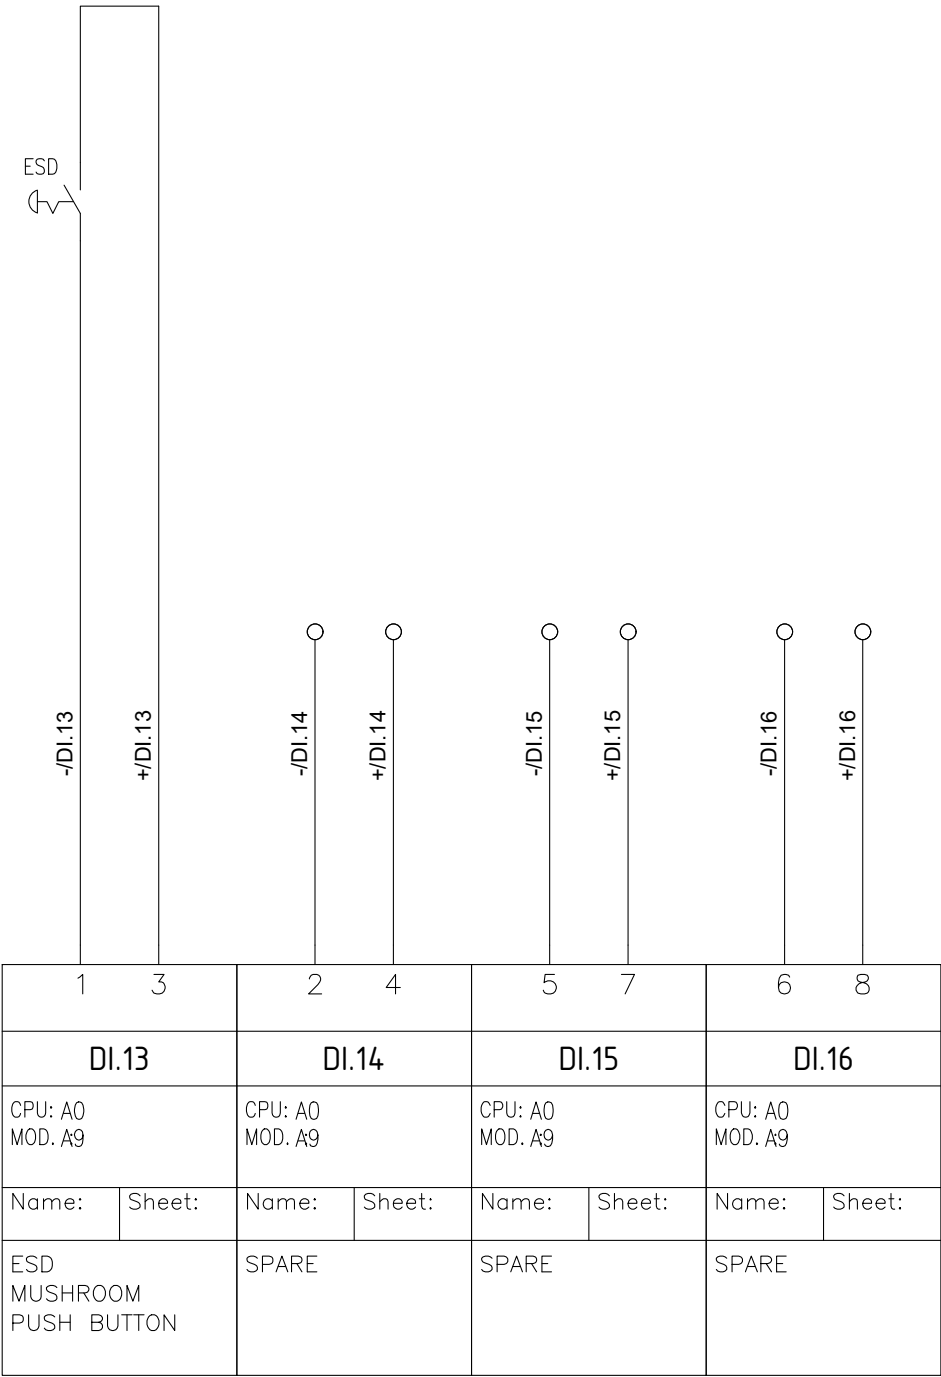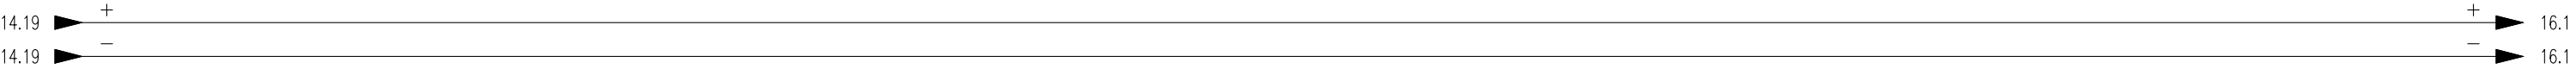


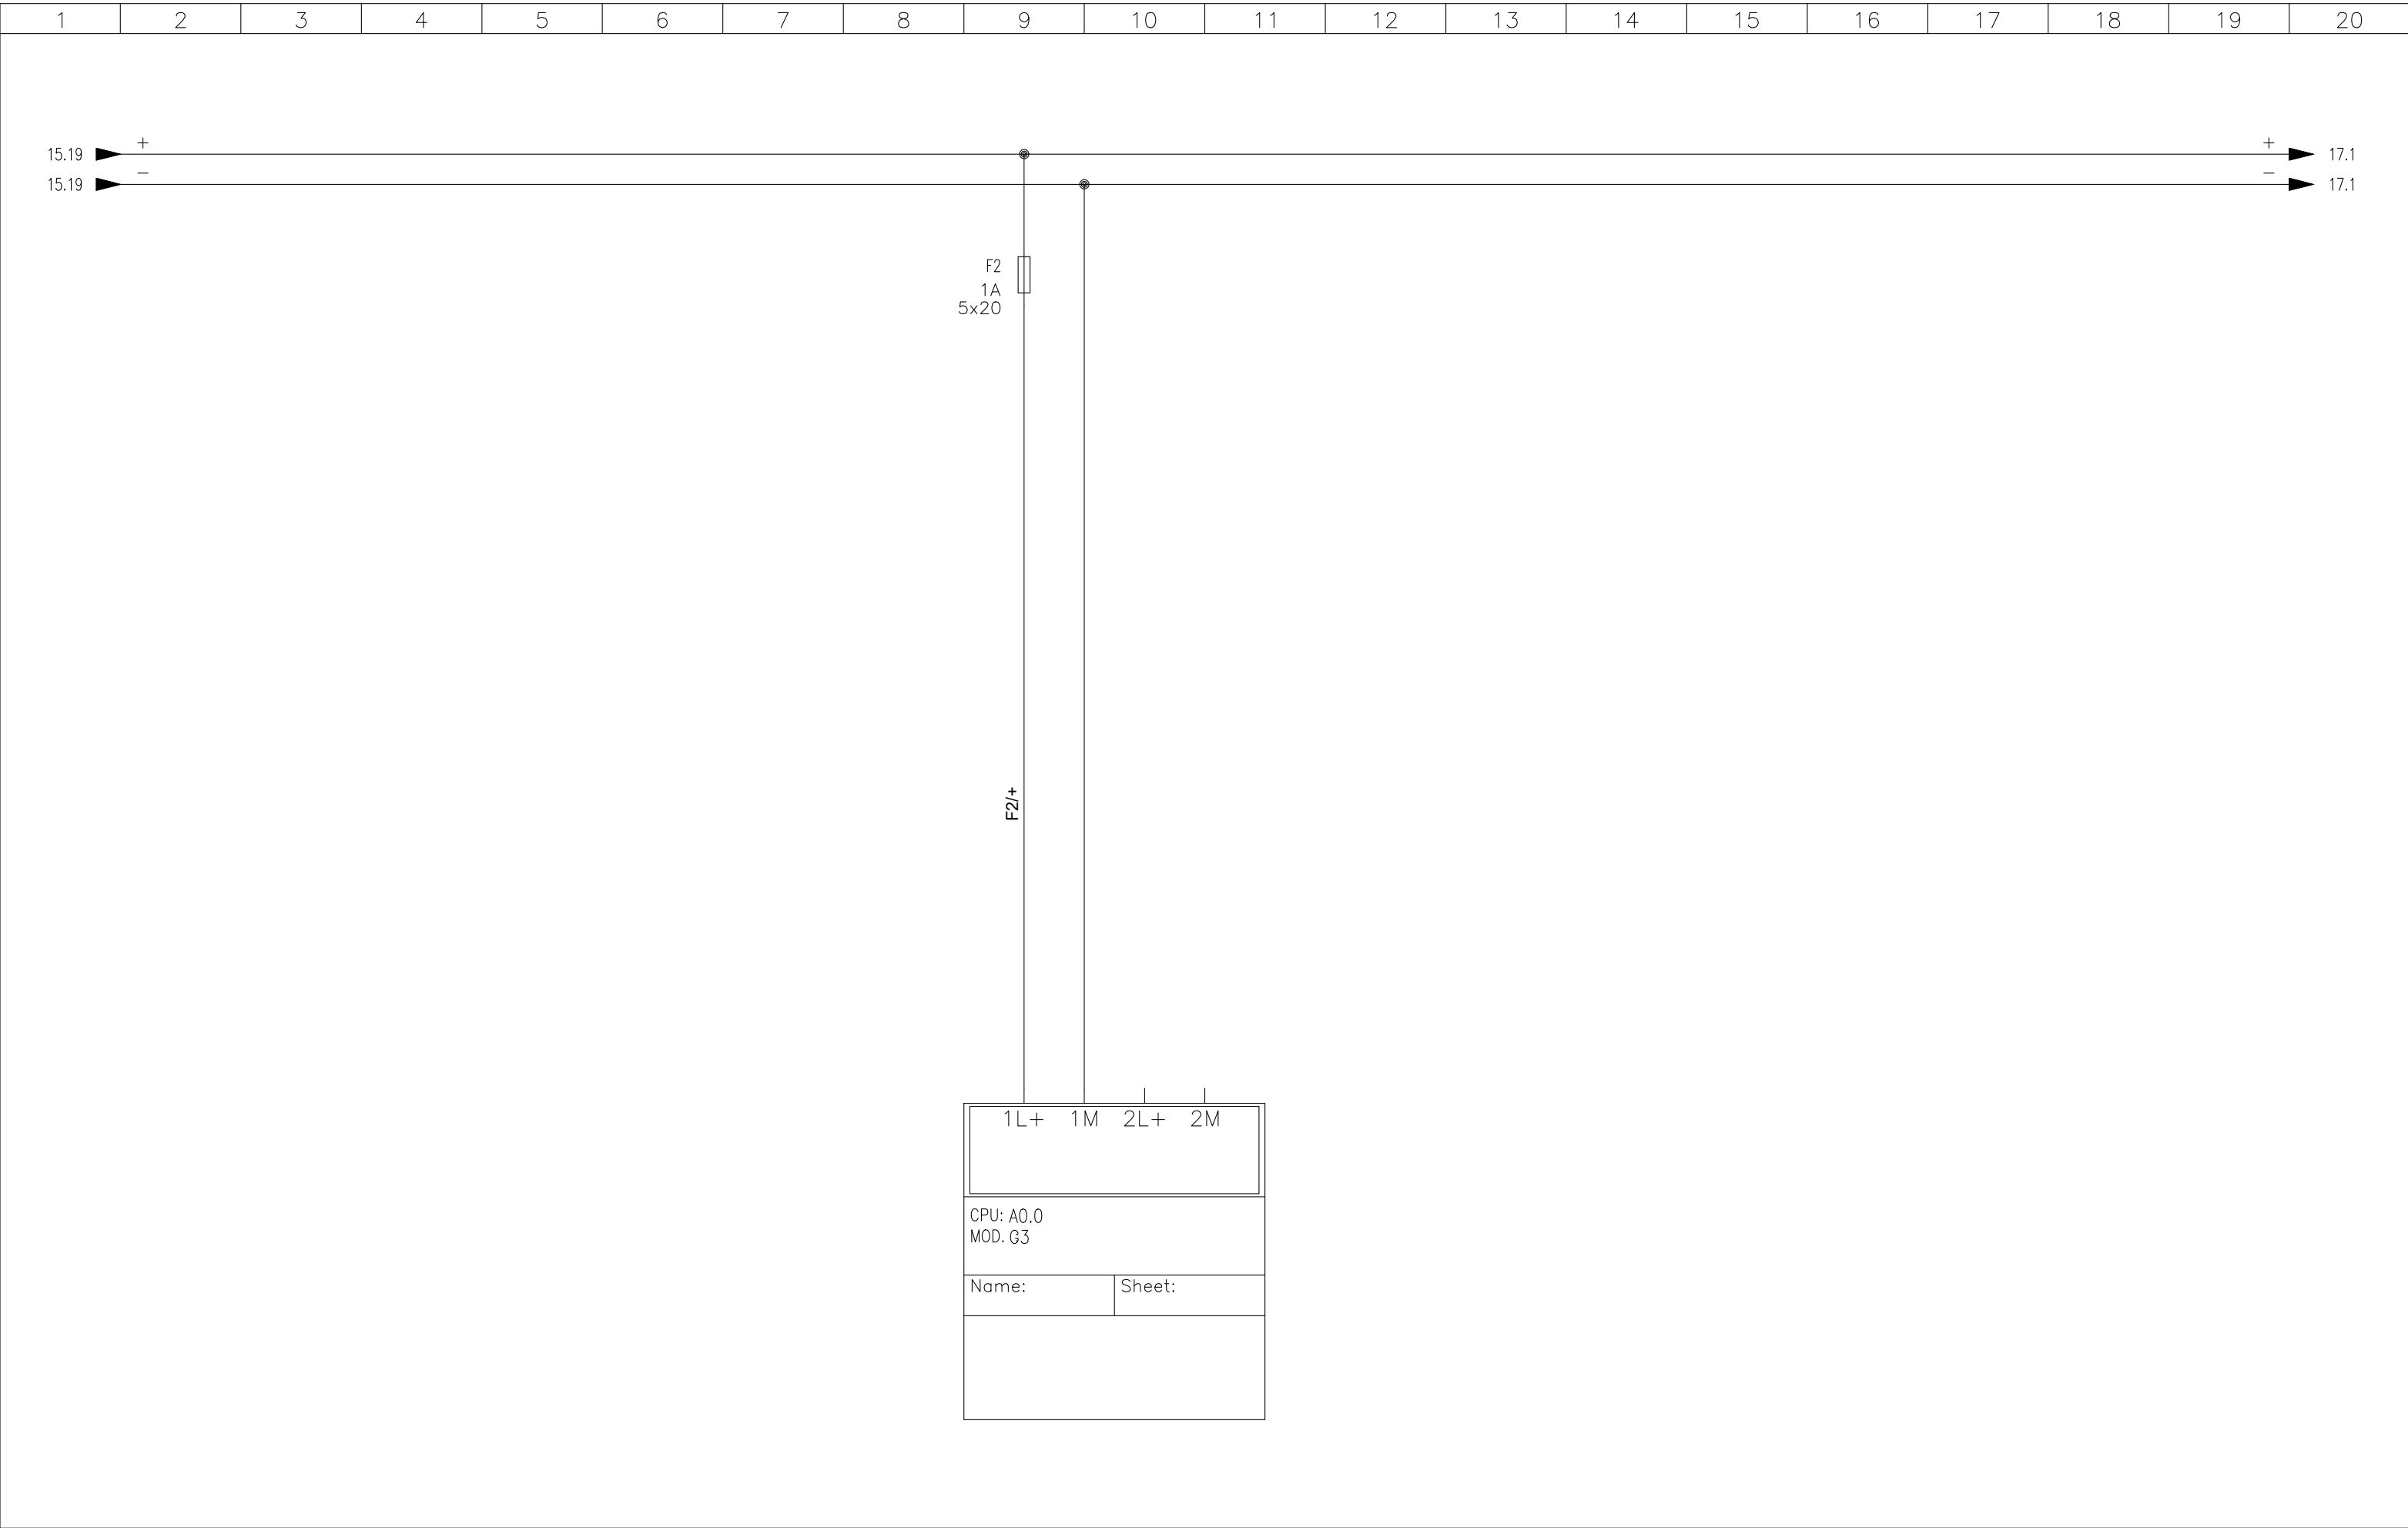





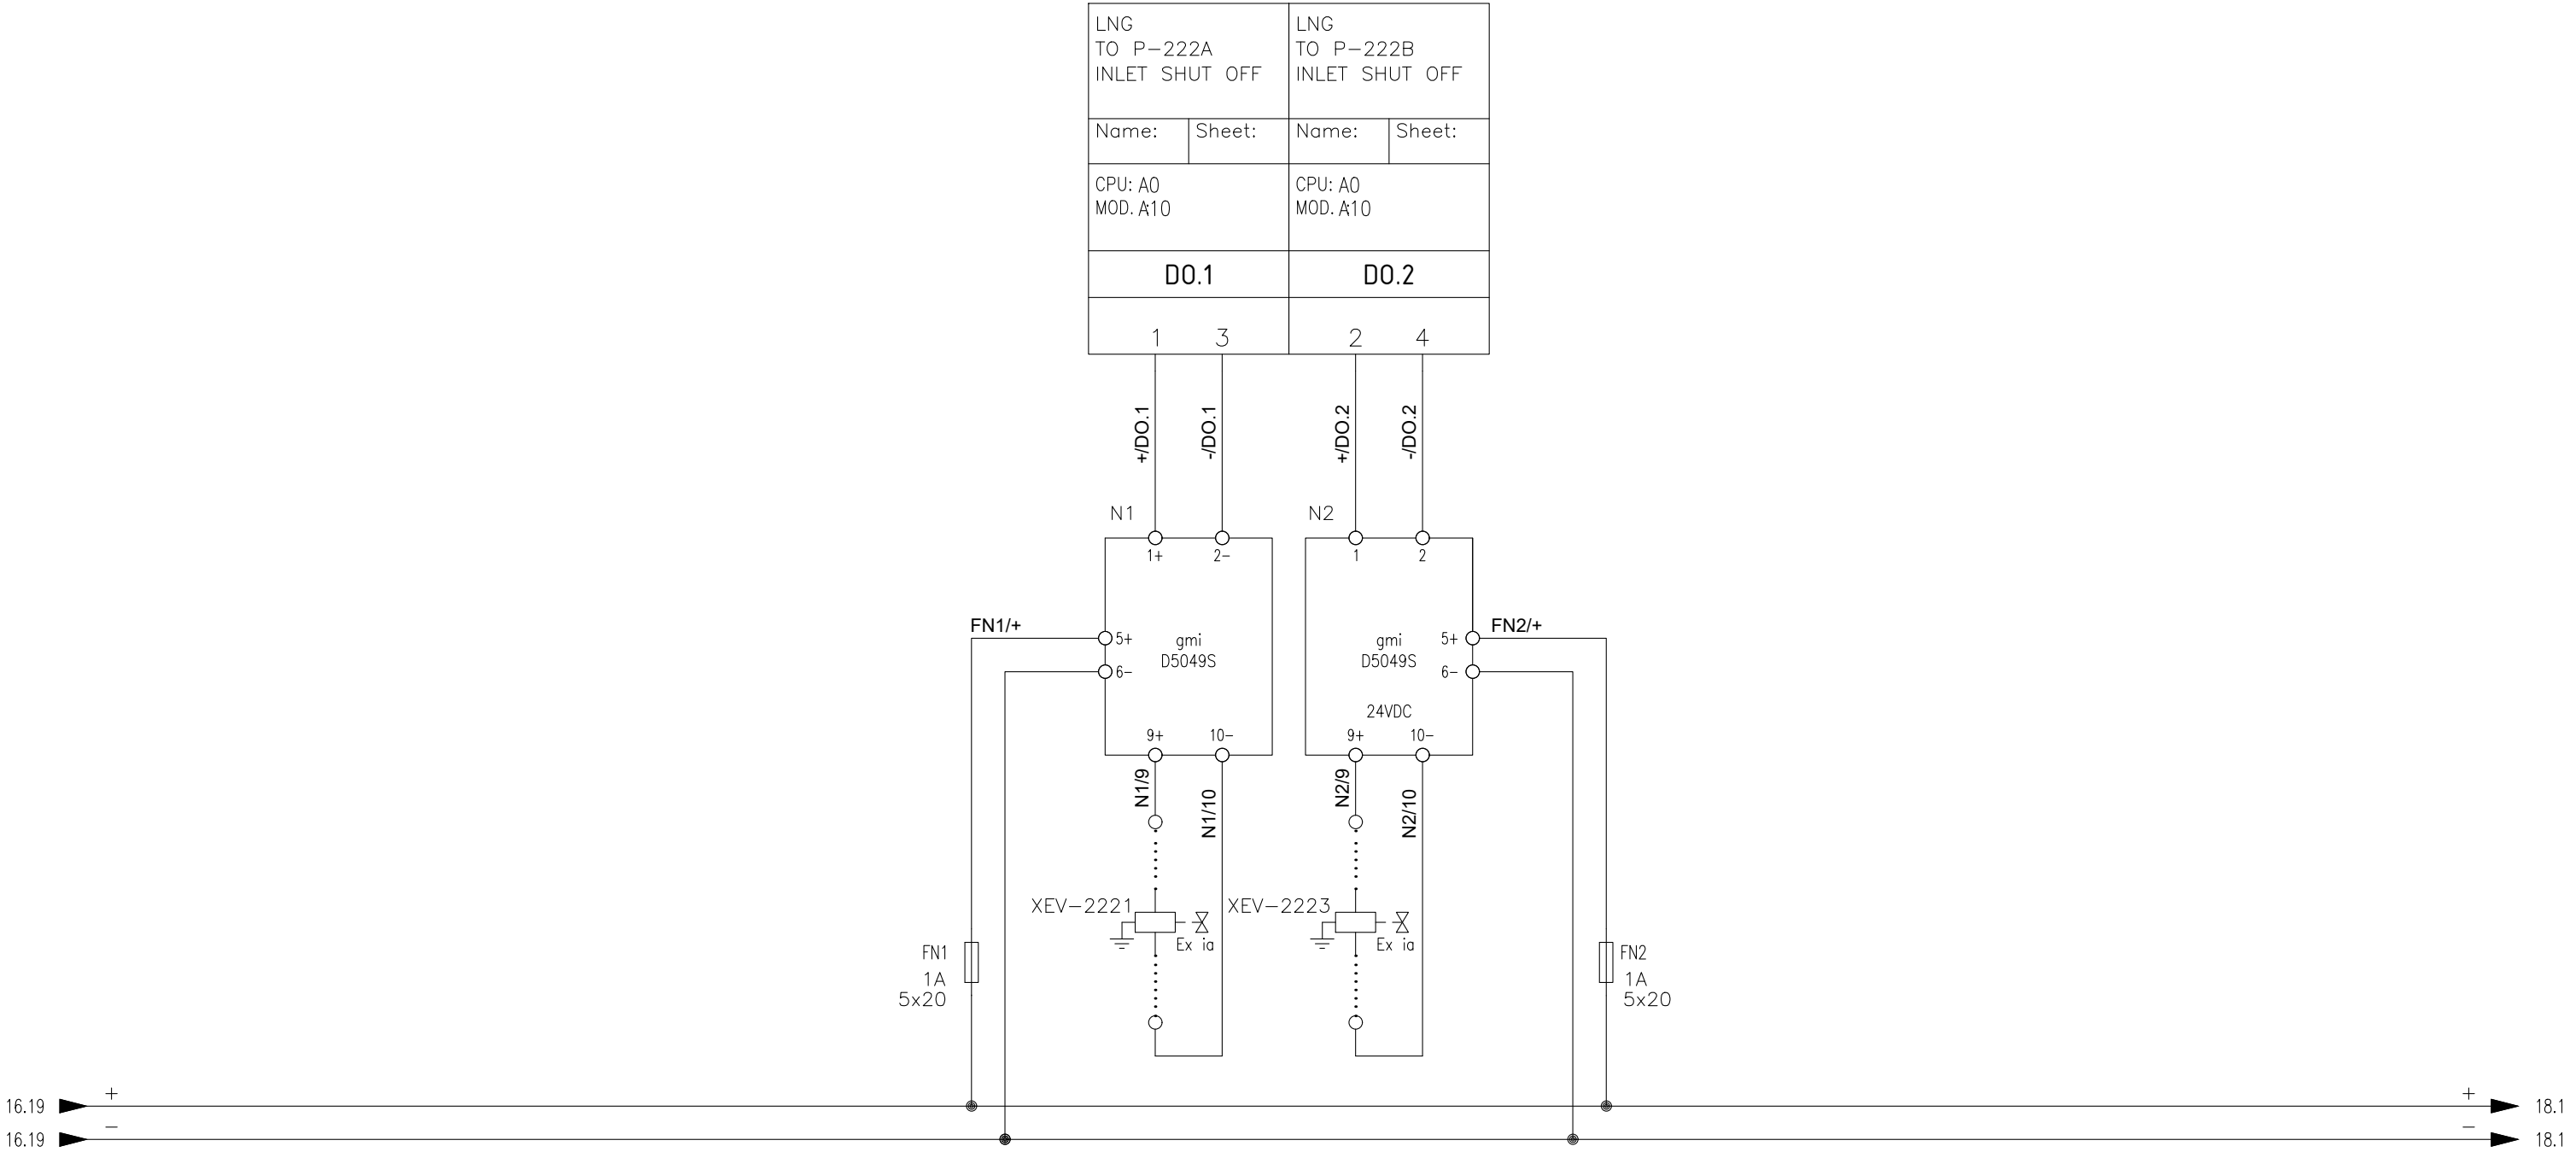


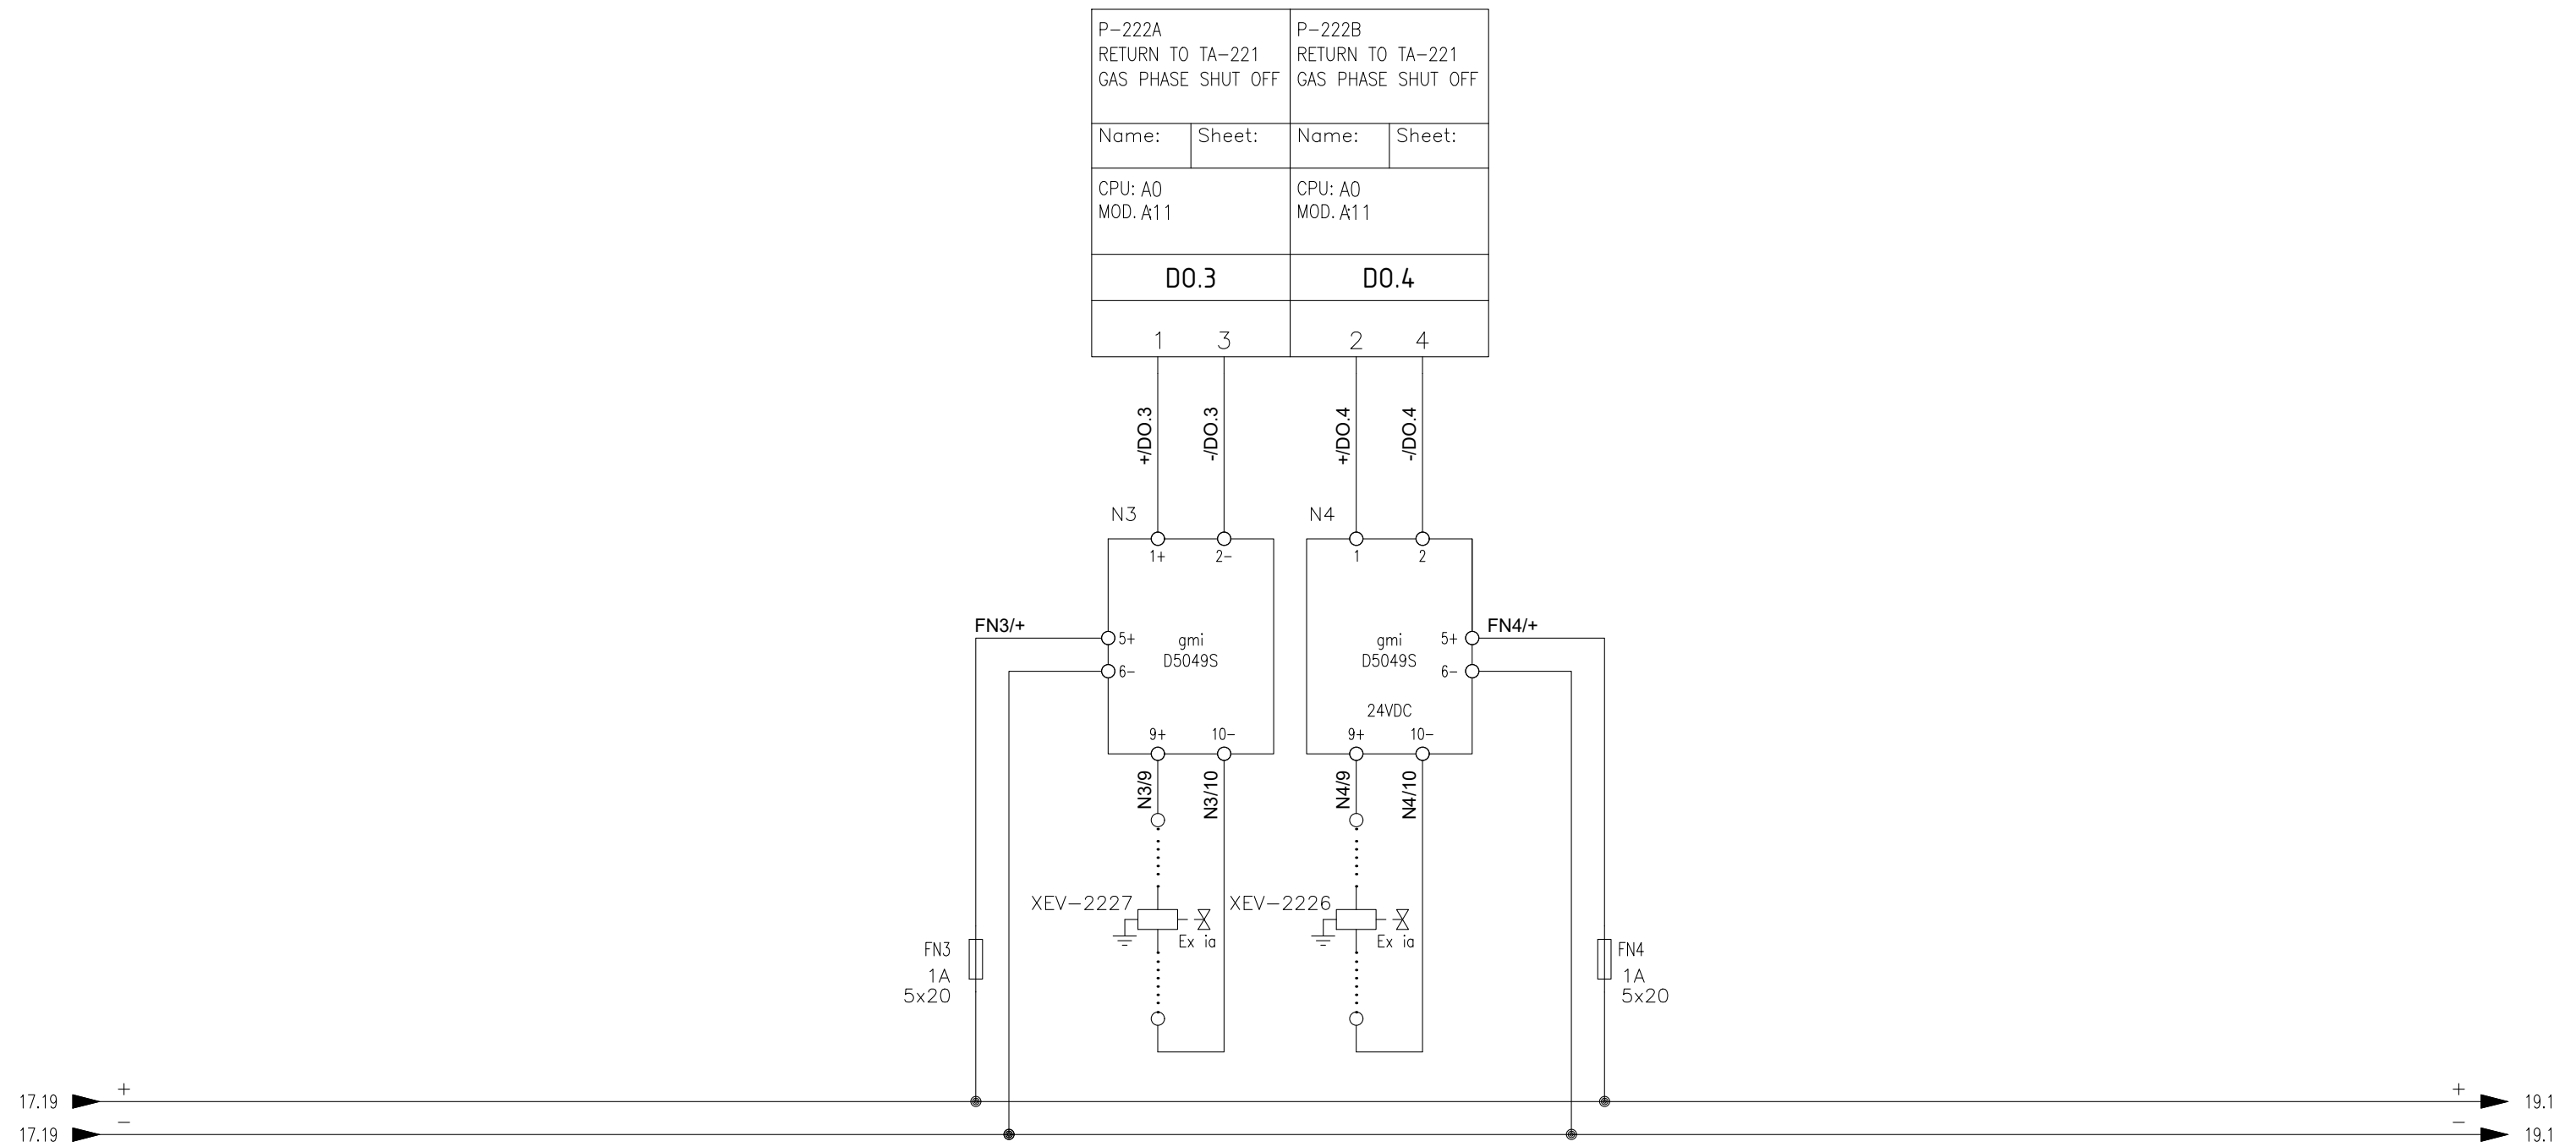


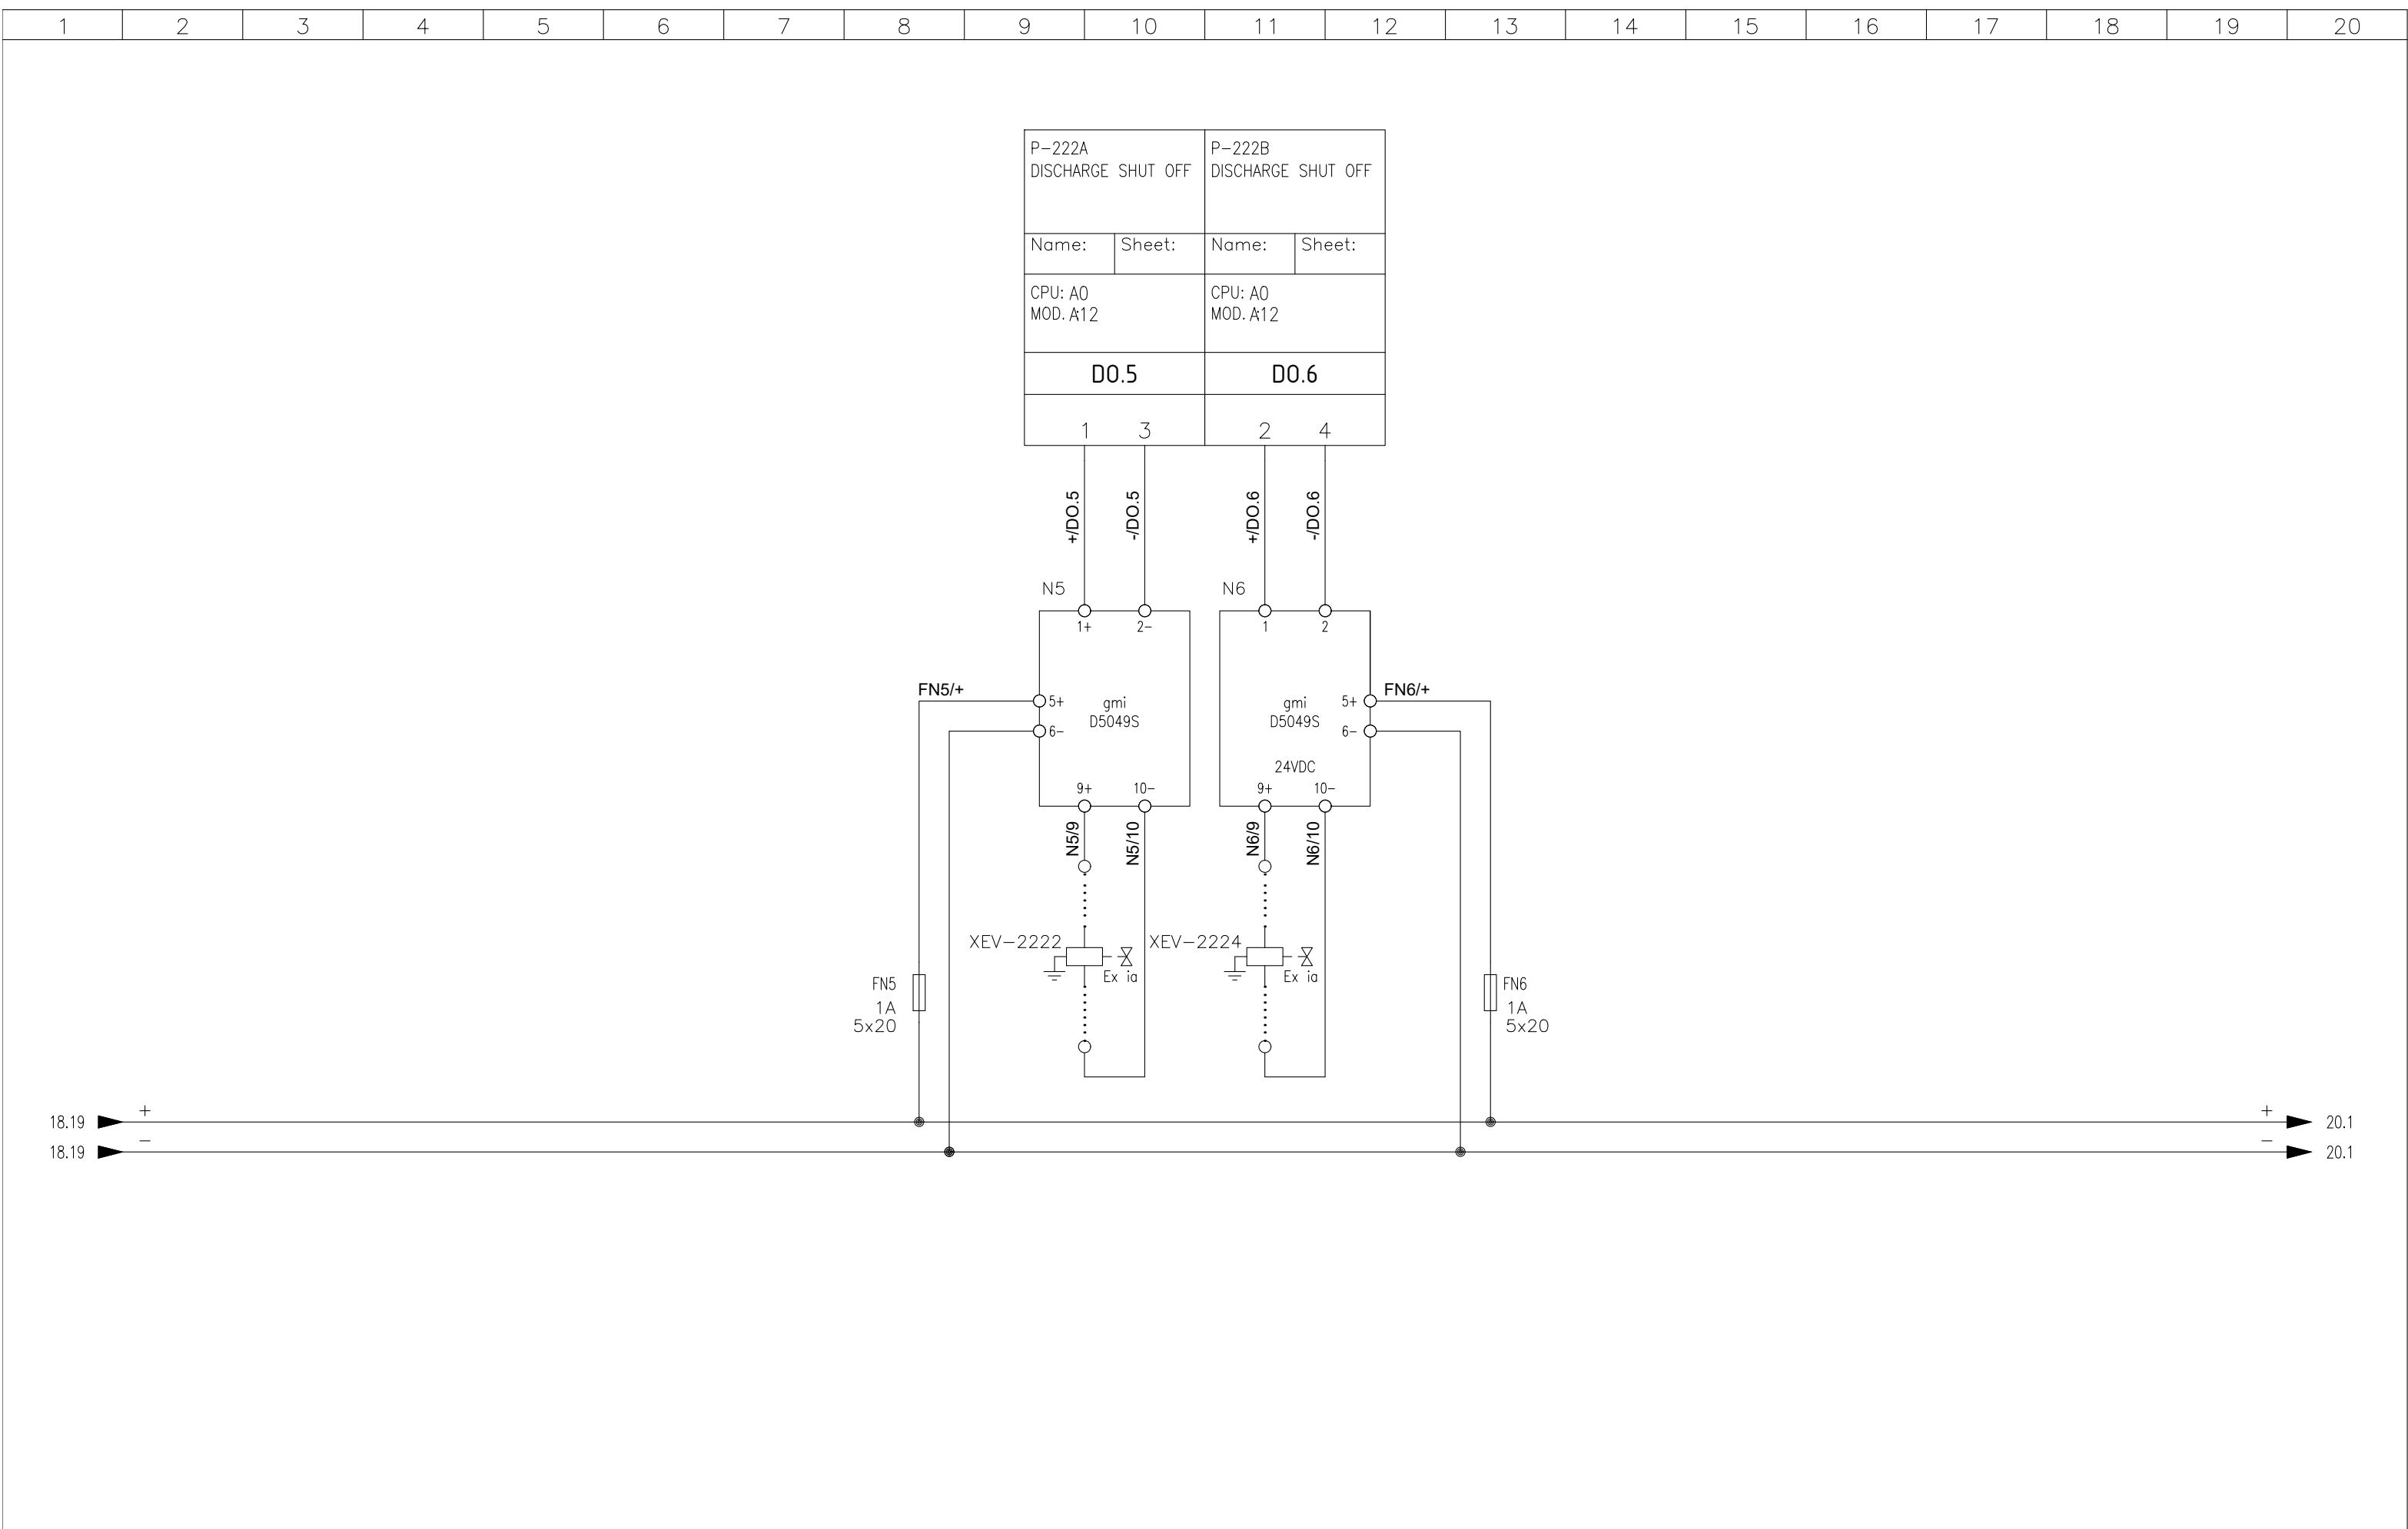

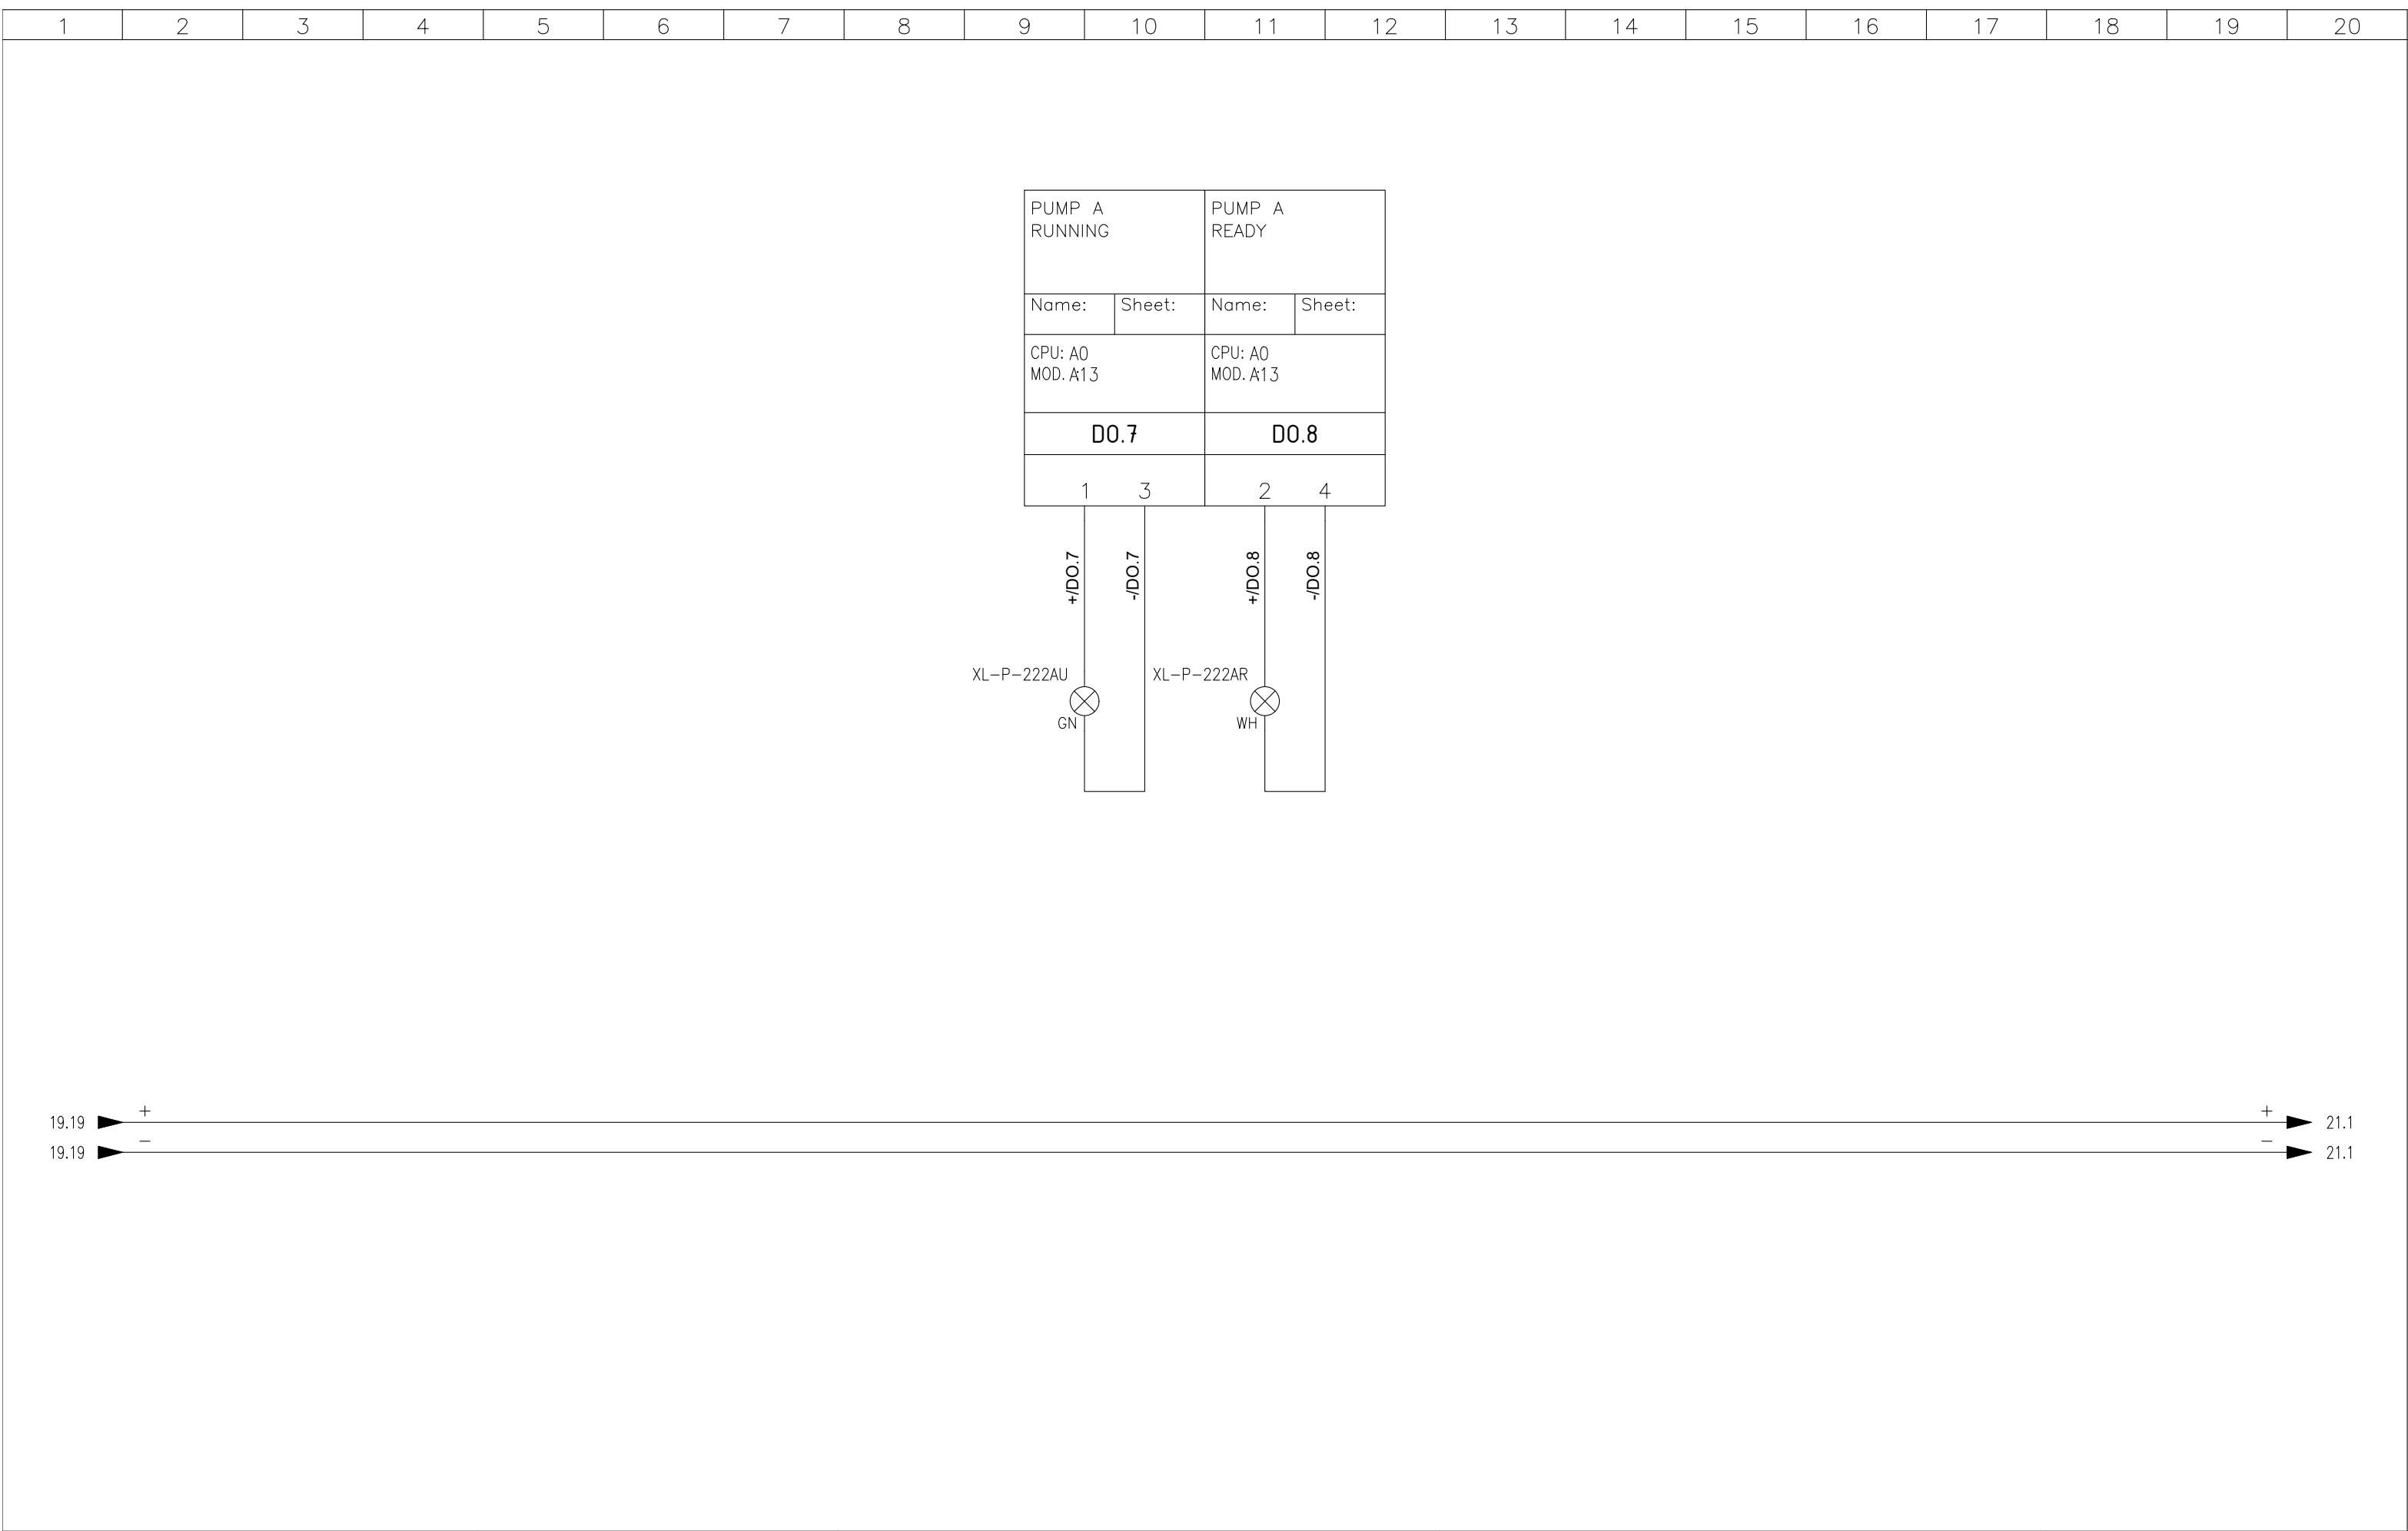

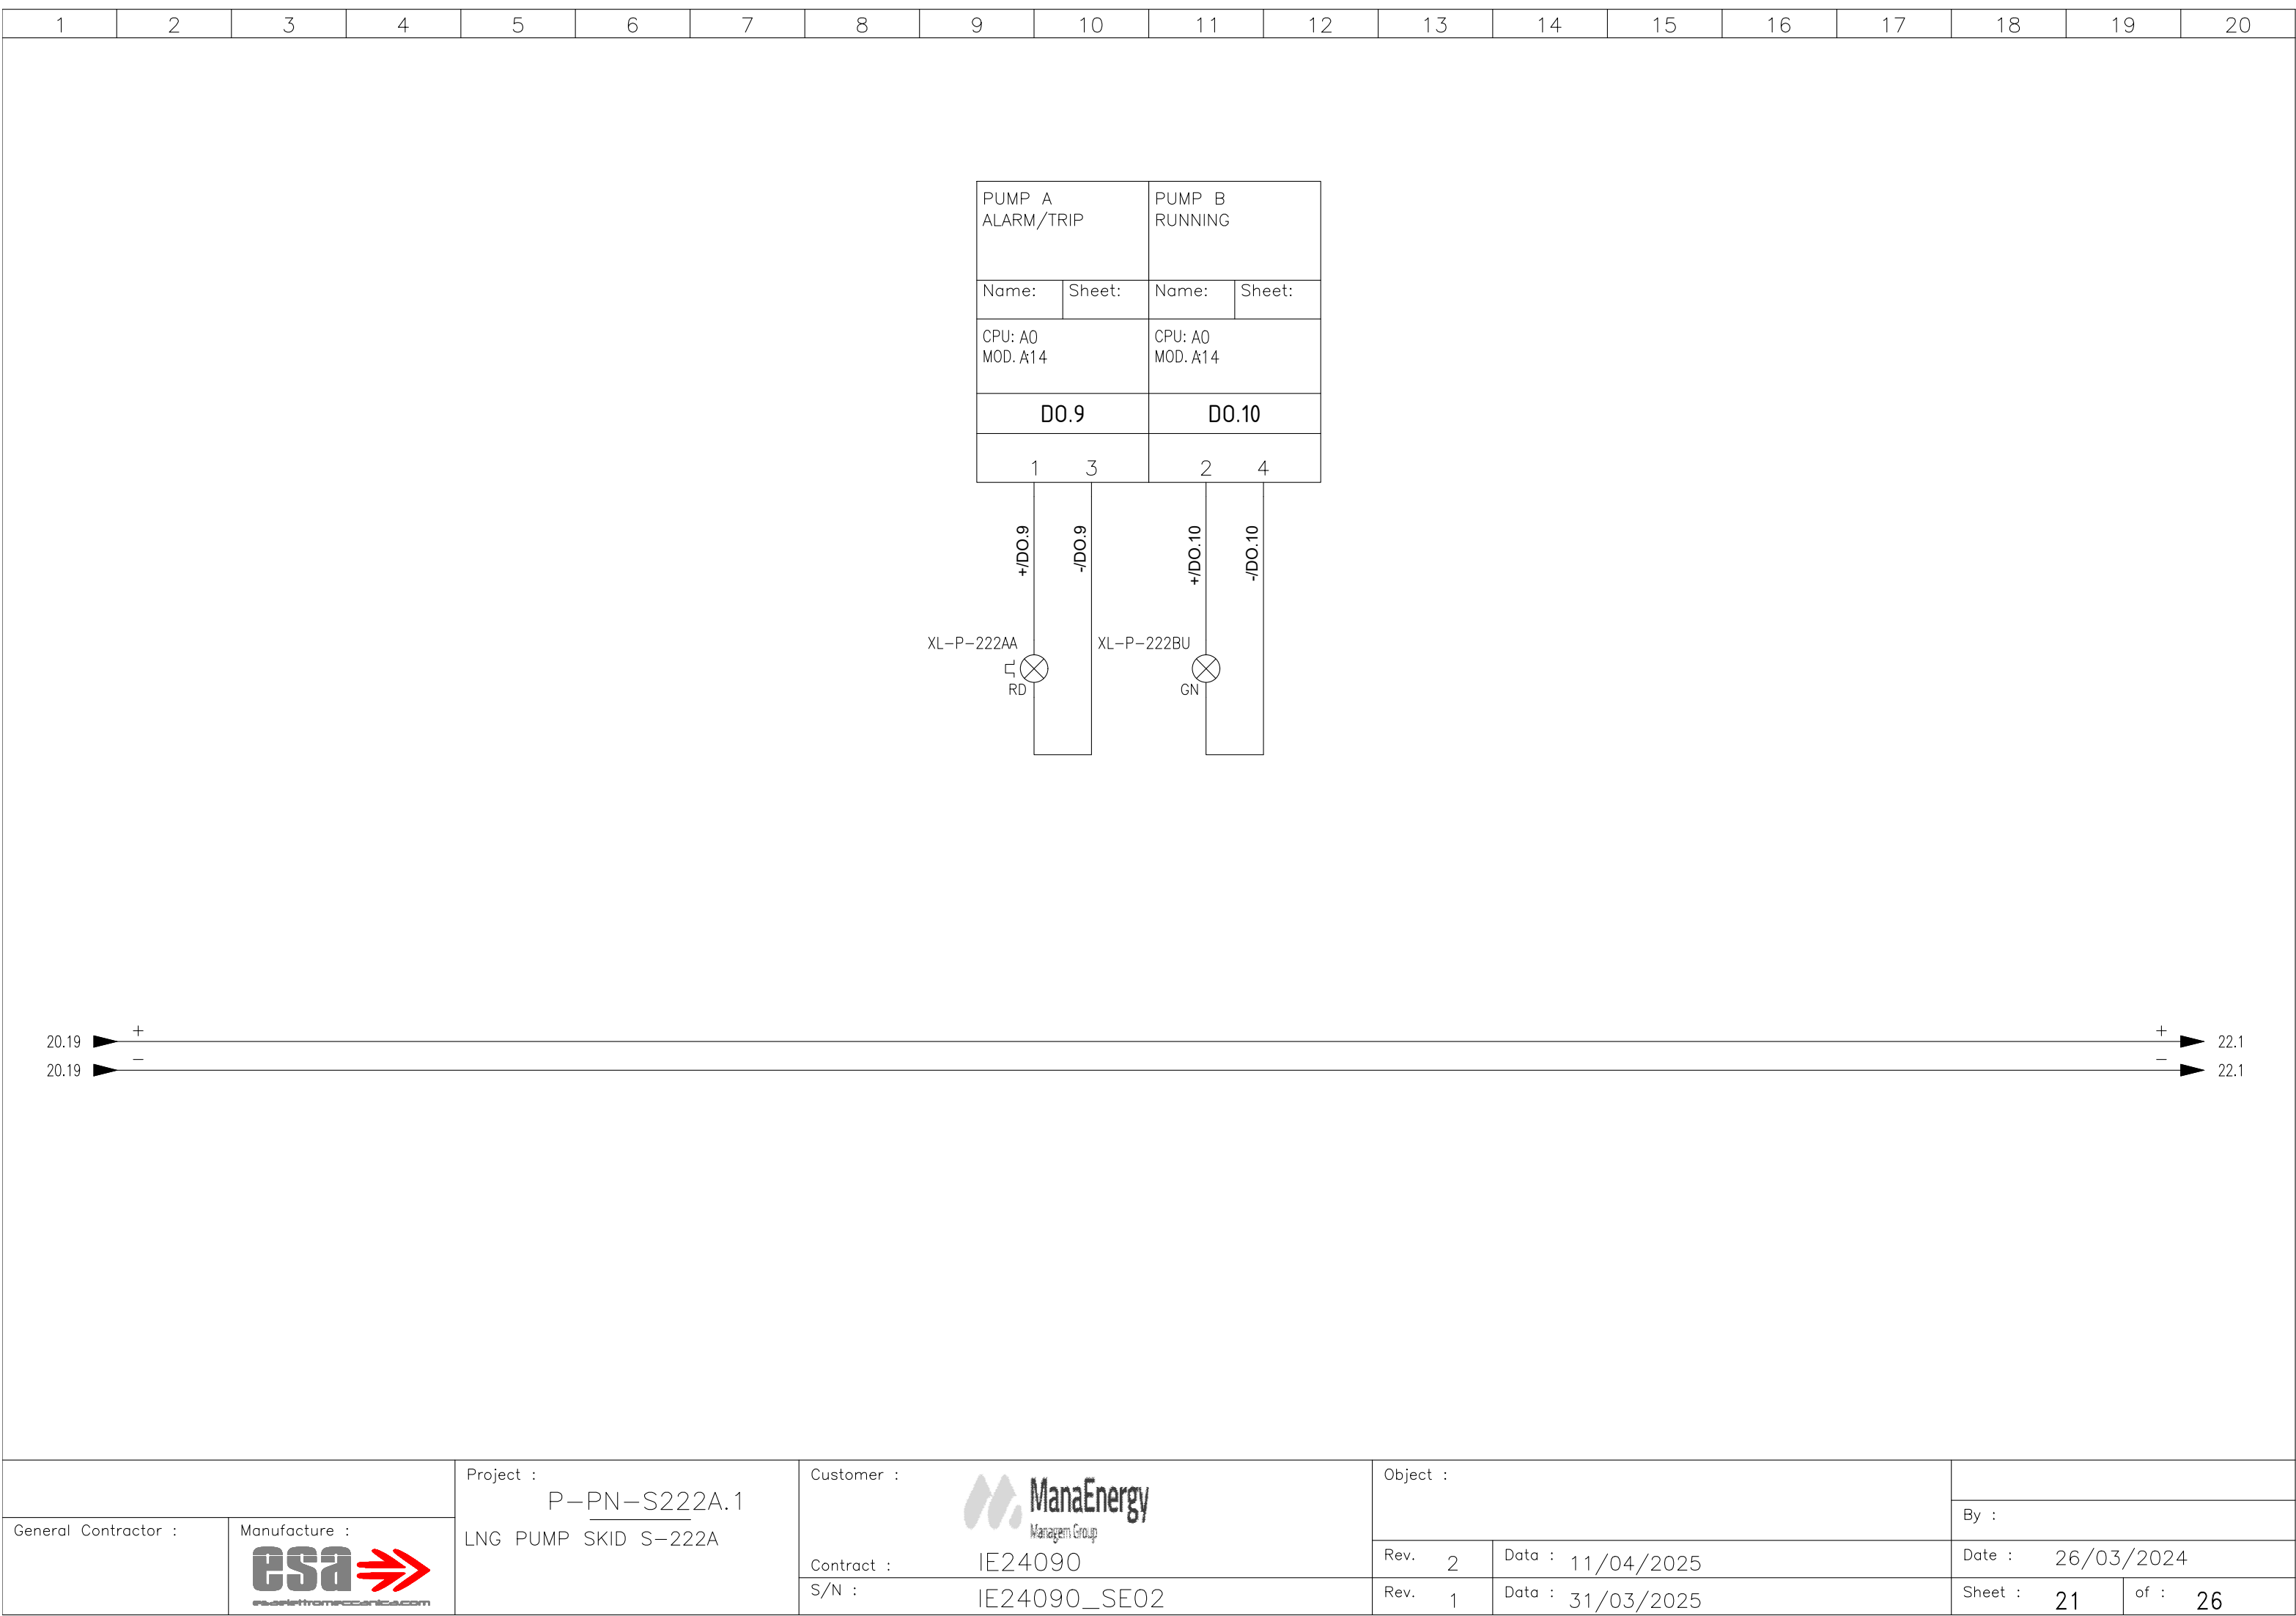






|                      |                                                                                                |                                                   |                                                                                                                |  |          |                   |                   |         |
|----------------------|------------------------------------------------------------------------------------------------|---------------------------------------------------|----------------------------------------------------------------------------------------------------------------|--|----------|-------------------|-------------------|---------|
|                      |                                                                                                | Project :<br>P-PN-S222A.1<br>LNG PUMP SKID S-222A | Customer :<br><div></div> |  | Object : |                   |                   |         |
| General Contractor : | <div></div> |                                                   | Contract : IE24090                                                                                             |  | Rev. 2   | Data : 11/04/2025 | Date : 26/03/2024 |         |
|                      |                                                                                                |                                                   | S/N : IE24090_SE02                                                                                             |  | Rev. 1   | Data : 31/03/2025 | Sheet : 21        | of : 26 |

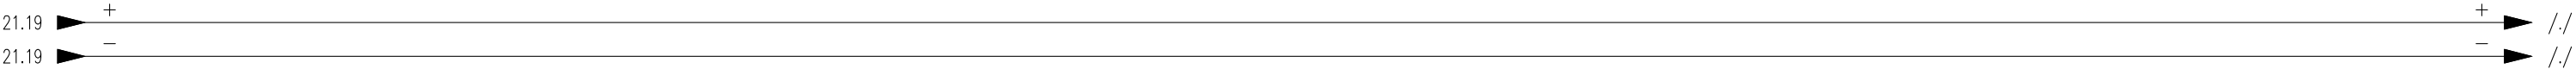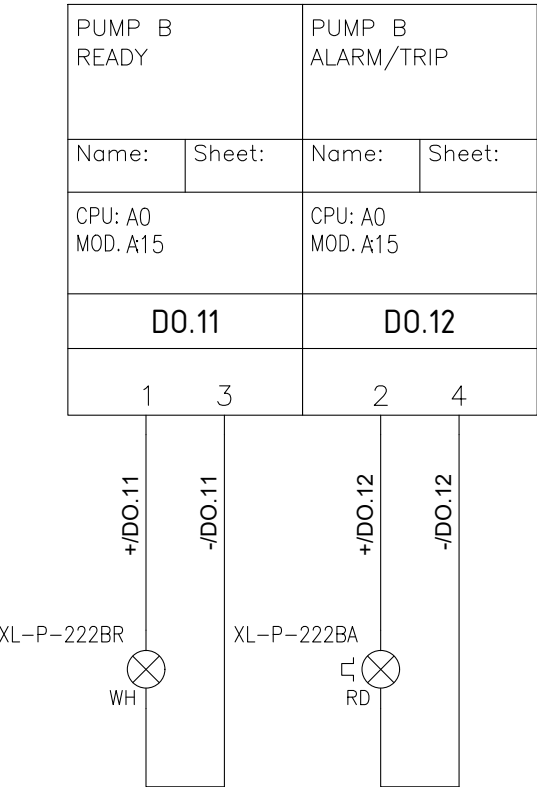



NOTE


- Type : EJB-7
- Ex-d [ia] IIB T6 IP65 ATEX -20/+50°C
- Installation area is zone 2 IIA T1
- Weight 350kg
- Power dissipation 120W

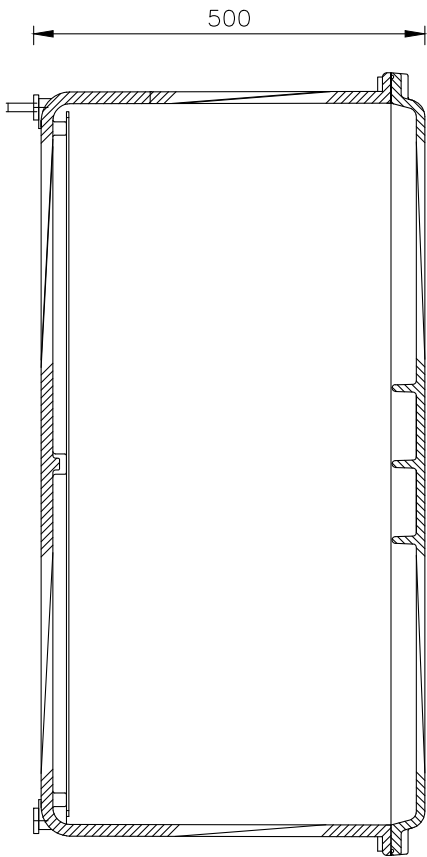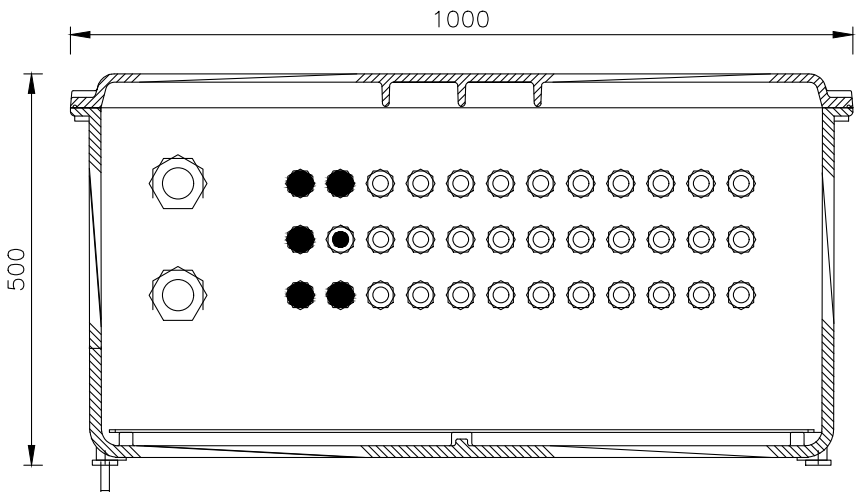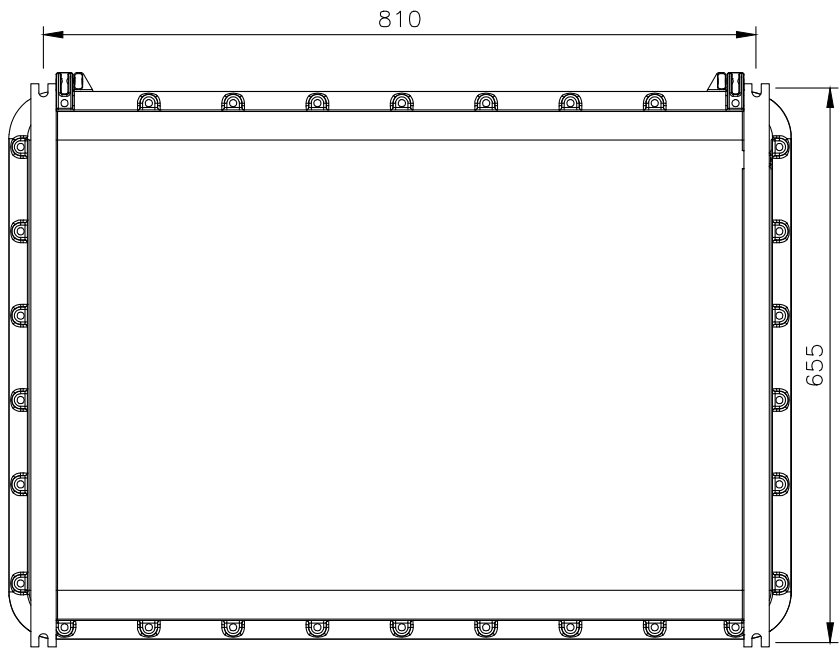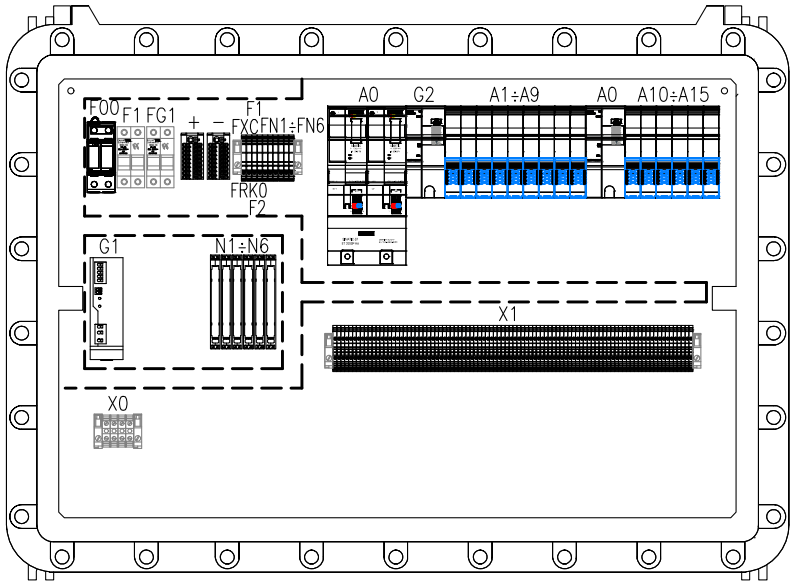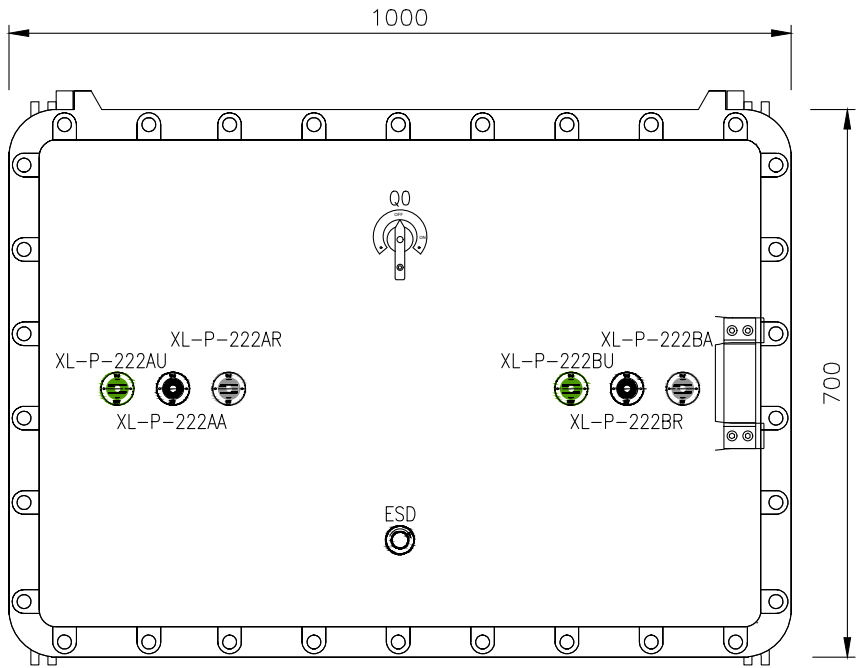

| INITIALS | SUPPLIER PN        | DESCRIPTION                                                                      | SUPPLIER        |
|----------|--------------------|----------------------------------------------------------------------------------|-----------------|
| –        | 3273110            | PTFIX 6/18X2,5–NS35 GY – Distribution block                                      | PHOENIX CONTACT |
| +        | 3273110            | PTFIX 6/18X2,5–NS35 GY – Distribution block                                      | PHOENIX CONTACT |
| A0       | 6DL1193–6MD00–0AA0 | ”GUIDA PROFILATA 1500MM (59”)”                                                   | SIEMENS         |
| A0       | 6DL1155–6AU00–0PM0 | ET 200SP HA, IM155–6 PN                                                          | SIEMENS         |
| A0       | 6DL1193–6AR00–0AA0 | ET 200SP HA, ADATTATORE DI BUS BA 2XRJ45                                         | SIEMENS         |
| A0       | 6DL1193–6BH00–0SM0 | MODULO SUPPORTO IM SINGLE                                                        | SIEMENS         |
| A1       | 6DL1193–6BP00–0DW0 | ET 200SP HA, Ex–BU TYPE W0                                                       | SIEMENS         |
| A1       | 6DL1134–6TB00–0HX1 | ET 200SP HA, EX–AI 2xI 2–WIRE HART                                               | SIEMENS         |
| A10      | 6DL1132–6EB00–0HX1 | ET 200SP HA, EX–DQ 2x23,1VDC/20MA                                                | SIEMENS         |
| A10      | 6DL1193–6BP00–0BX1 | ET 200SP HA, Ex–BU TYPE X1                                                       | SIEMENS         |
| A11      | 6DL1132–6EB00–0HX1 | ET 200SP HA, EX–DQ 2x23,1VDC/20MA                                                | SIEMENS         |
| A11      | 6DL1193–6BP00–0BX1 | ET 200SP HA, Ex–BU TYPE X1                                                       | SIEMENS         |
| A12      | 6DL1132–6EB00–0HX1 | ET 200SP HA, EX–DQ 2x23,1VDC/20MA                                                | SIEMENS         |
| A12      | 6DL1193–6BP00–0BX1 | ET 200SP HA, Ex–BU TYPE X1                                                       | SIEMENS         |
| A13      | 6DL1132–6EB00–0HX1 | ET 200SP HA, EX–DQ 2x23,1VDC/20MA                                                | SIEMENS         |
| A13      | 6DL1193–6BP00–0BX1 | ET 200SP HA, Ex–BU TYPE X1                                                       | SIEMENS         |
| A14      | 6DL1132–6EB00–0HX1 | ET 200SP HA, EX–DQ 2x23,1VDC/20MA                                                | SIEMENS         |
| A14      | 6DL1193–6BP00–0BX1 | ET 200SP HA, Ex–BU TYPE X1                                                       | SIEMENS         |
| A15      | 6DL1132–6EB00–0HX1 | ET 200SP HA, EX–DQ 2x23,1VDC/20MA                                                | SIEMENS         |
| A15      | 6DL1193–6BP00–0BX1 | ET 200SP HA, Ex–BU TYPE X1                                                       | SIEMENS         |
| A2       | 6DL1193–6BP00–0DW0 | ET 200SP HA, Ex–BU TYPE W0                                                       | SIEMENS         |
| A2       | 6DL1134–6TB00–0HX1 | ET 200SP HA, EX–AI 2xI 2–WIRE HART                                               | SIEMENS         |
| A3       | 6DL1193–6BP00–0DW0 | ET 200SP HA, Ex–BU TYPE W0                                                       | SIEMENS         |
| A3       | 6DL1134–6TB00–0HX1 | ET 200SP HA, EX–AI 2xI 2–WIRE HART                                               | SIEMENS         |
| A4       | 6DL1193–6BP00–0BX1 | ET 200SP HA, Ex–BU TYPE X1                                                       | SIEMENS         |
| A4       | 6DL1134–6JD00–0HX1 | ET 200SP HA, EX–AI 4xTC/2xRTD 2–/3–/4–W                                          | SIEMENS         |
| A5       | 6DL1193–6BP00–0BX1 | ET 200SP HA, Ex–BU TYPE X1                                                       | SIEMENS         |
| A5       | 6DL1134–6JD00–0HX1 | ET 200SP HA, EX–AI 4xTC/2xRTD 2–/3–/4–W                                          | SIEMENS         |
| A6       | 6DL1131–6TD00–0HX1 | ET 200SP HA, EX–DI 4xNAMUR                                                       | SIEMENS         |
| A6       | 6DL1193–6BP00–0BX1 | ET 200SP HA, Ex–BU TYPE X1                                                       | SIEMENS         |
| A7       | 6DL1131–6TD00–0HX1 | ET 200SP HA, EX–DI 4xNAMUR                                                       | SIEMENS         |
| A7       | 6DL1193–6BP00–0BX1 | ET 200SP HA, Ex–BU TYPE X1                                                       | SIEMENS         |
| A8       | 6DL1131–6TD00–0HX1 | ET 200SP HA, EX–DI 4xNAMUR                                                       | SIEMENS         |
| A8       | 6DL1193–6BP00–0BX1 | ET 200SP HA, Ex–BU TYPE X1                                                       | SIEMENS         |
| A9       | 6DL1131–6TD00–0HX1 | ET 200SP HA, EX–DI 4xNAMUR                                                       | SIEMENS         |
| A9       | 6DL1193–6BP00–0BX1 | ET 200SP HA, Ex–BU TYPE X1                                                       | SIEMENS         |
| ESD      | M–0445             | RED EMERGENCY PUSH-BUTTON , TURN TO RELEASE, 1 N.O. + 1 N.C. CONTACTS            | CORTEM          |
| F00      | 952110             | DG M TT 2P 275 – SPD                                                             | DEHN            |
| F1       | 2302038            | Fuseholder for cylindrical fuses – 2P for fuses 10,3x38mm – BCH 2x38 32A 690V    | ITALWEBER       |
| F1       | TBS4F              | MODULAR TERMINAL WITH FUSE                                                       | CEMBRE          |
| F2       | TBS4F              | MODULAR TERMINAL WITH FUSE                                                       | CEMBRE          |
| FG1      | 2301138            | Fuseholder for cylindrical fuses – 1P+N for fuses 10,3x38mm – BCH 1x38N 32A 690V | ITALWEBER       |
| FN1      | TBS4F              | MODULAR TERMINAL WITH FUSE                                                       | CEMBRE          |
| FN2      | TBS4F              | MODULAR TERMINAL WITH FUSE                                                       | CEMBRE          |
| FN3      | TBS4F              | MODULAR TERMINAL WITH FUSE                                                       | CEMBRE          |
| FN4      | TBS4F              | MODULAR TERMINAL WITH FUSE                                                       | CEMBRE          |
| FN5      | TBS4F              | MODULAR TERMINAL WITH FUSE                                                       | CEMBRE          |
| FN6      | TBS4F              | MODULAR TERMINAL WITH FUSE                                                       | CEMBRE          |
| FRK0     | TBS4F              | MODULAR TERMINAL WITH FUSE                                                       | CEMBRE          |
| FXC      | TBS4F              | MODULAR TERMINAL WITH FUSE                                                       | CEMBRE          |
| G1       | 2903149            | TRIO–PS–2G/1AC/24DC/10 – Power supply unit                                       | PHOENIX CONTACT |
| G2       | 6DL1133–6PX00–0HW0 | ET 200SP HA, Ex–PM E POWER MODULE                                                | SIEMENS         |
| G3       | 6DL1133–6PX00–0HW0 | ET 200SP HA, Ex–PM E POWER MODULE                                                | SIEMENS         |
| N1       | D5049S             | I.S. SIL3 Bus–Powered Digital Output Driver                                      | GMI             |
| N2       | D5049S             | I.S. SIL3 Bus–Powered Digital Output Driver                                      | GMI             |
| N3       | D5049S             | I.S. SIL3 Bus–Powered Digital Output Driver                                      | GMI             |
| N4       | D5049S             | I.S. SIL3 Bus–Powered Digital Output Driver                                      | GMI             |
| N5       | D5049S             | I.S. SIL3 Bus–Powered Digital Output Driver                                      | GMI             |
| N6       | D5049S             | I.S. SIL3 Bus–Powered Digital Output Driver                                      | GMI             |


| INITIALS   | SUPPLIER PN  | DESCRIPTION                                                                          | SUPPLIER |
|------------|--------------|--------------------------------------------------------------------------------------|----------|
| P-PN-S222A | EJB–7        | ENCLOSURE 1000x700x510 mm L x H x D                                                  | CORTEM   |
| P-PN-S222A | BFE–7        | INTERNAL FRAME                                                                       | CORTEM   |
| Q0         | M–0553L      | EXTERNAL HANDLE, PADLOCKABLE                                                         | CORTEM   |
| Q0         | A3–10E/R     | ”SONTHEIMER NOT AUTOMATIC SWITCH ””ON–OFF””, 3P,10A,PADLOCKABLE IN ””OFF”” POSITION” | CORTEM   |
| XL-P-222AR | M–0457/3I230 | SIGNALLING LED WHITE COLOUR 230V                                                     | CORTEM   |
| XL-P-222AU | M–0457/3V230 | SIGNALLING LED GREEN COLOUR 230V                                                     | CORTEM   |
| XL-P-222BA | M–0457/3I230 | SIGNALLING LED WHITE COLOUR 230V                                                     | CORTEM   |
| XL-P-222BR | M–0457/3V230 | SIGNALLING LED GREEN COLOUR 230V                                                     | CORTEM   |
| XL-P-222BU | M–0457/3V230 | SIGNALLING LED GREEN COLOUR 230V                                                     | CORTEM   |
| XL-P-222BU | M–0457/3V230 | SIGNALLING LED GREEN COLOUR 230V                                                     | CORTEM   |




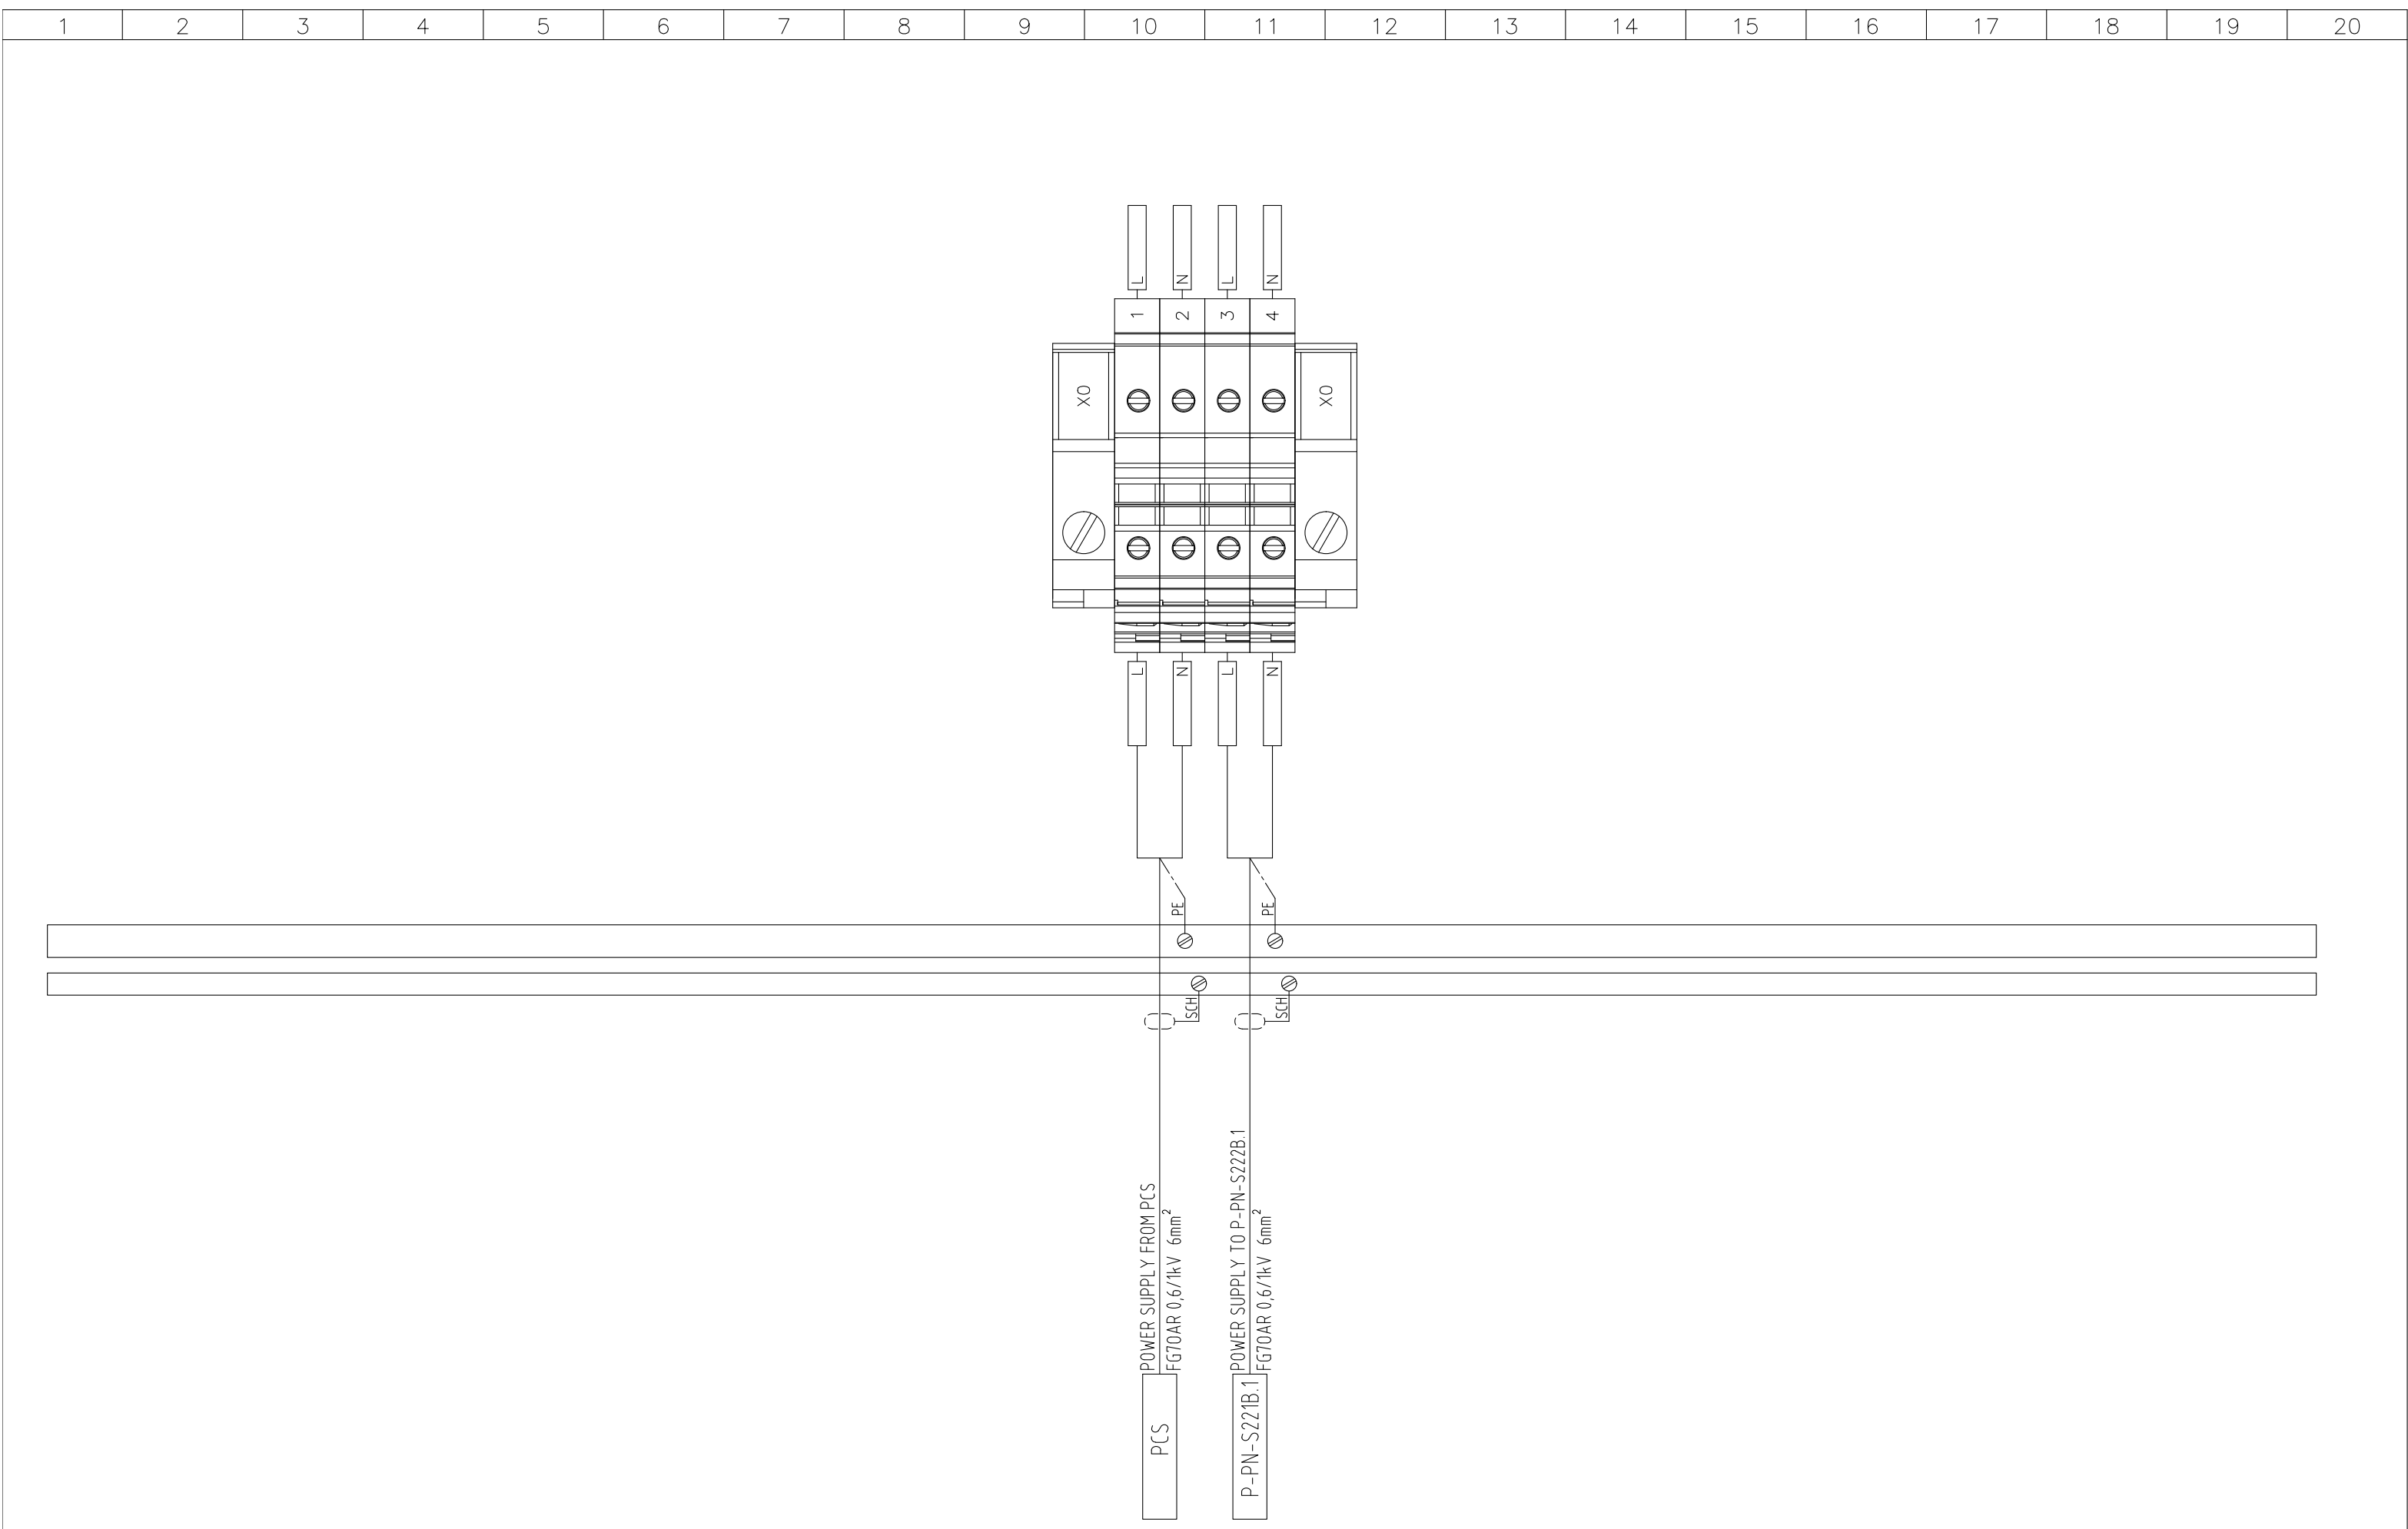

|                      |  |                                                                                                      |                                                   |                                                                                                     |          |                   |                   |         |  |
|----------------------|--|------------------------------------------------------------------------------------------------------|---------------------------------------------------|-----------------------------------------------------------------------------------------------------|----------|-------------------|-------------------|---------|--|
| General Contractor : |  | Manufacture :<br> | Project :<br>P-PN-S222A.1<br>LNG PUMP SKID S-222A | Customer :<br> | Object : |                   |                   |         |  |
|                      |  |                                                                                                      |                                                   |                                                                                                     |          |                   | By :              |         |  |
|                      |  | Contract : IE24090                                                                                   |                                                   |                                                                                                     | Rev. 2   | Data : 11/04/2025 | Date : 26/03/2024 |         |  |
|                      |  | S/N : IE24090_SE02                                                                                   |                                                   |                                                                                                     | Rev. 1   | Data : 31/03/2025 | Sheet : 25        | of : 26 |  |

 INTRINSIC CIRCUIT INSIDE

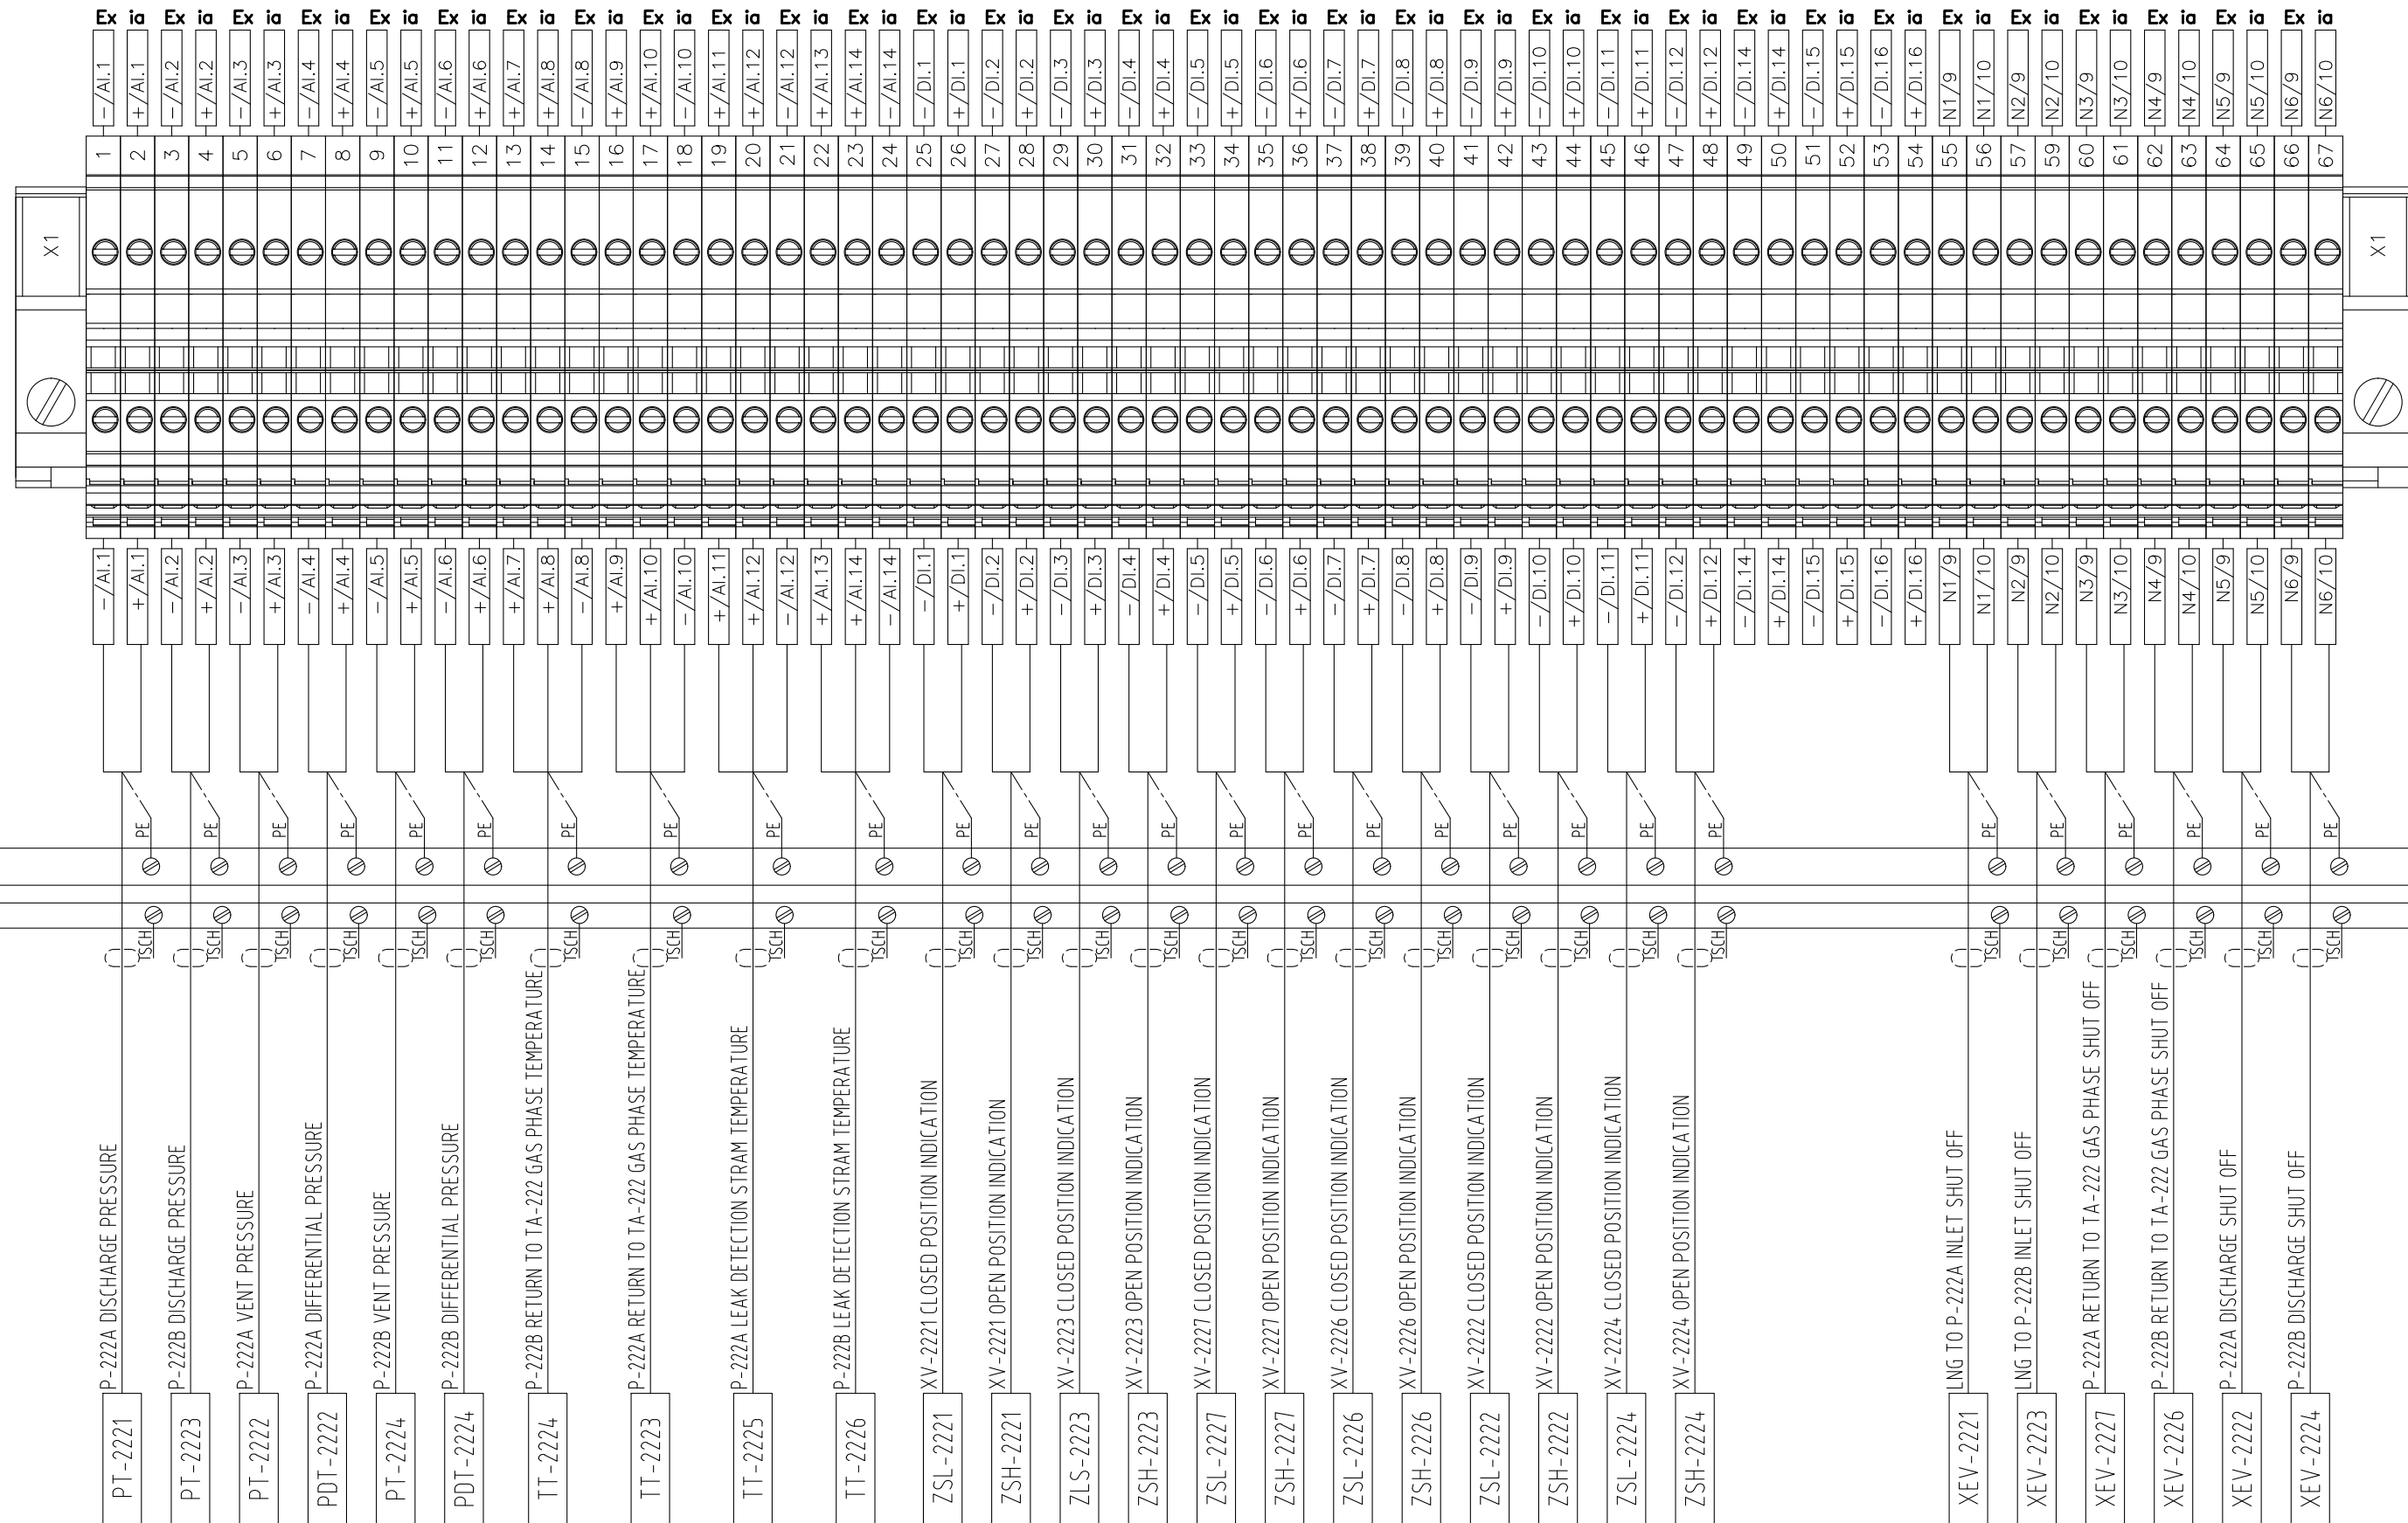

|                                                                                                                                  |  |                                                       |                                                                                                     |                   |                   |                   |  |
|----------------------------------------------------------------------------------------------------------------------------------|--|-------------------------------------------------------|-----------------------------------------------------------------------------------------------------|-------------------|-------------------|-------------------|--|
| General Contractor :<br><br>Manufacture :<br> |  | Project :<br>P-PN-S222A.1<br><br>LNG PUMP SKID S-222A | Customer :<br> | Object :          |                   | By :              |  |
|                                                                                                                                  |  |                                                       |                                                                                                     | Rev. 2            | Data : 11/04/2025 | Date : 26/03/2024 |  |
|                                                                                                                                  |  | Contract : IE24090                                    | Rev. 1                                                                                              | Data : 31/03/2025 | Sheet : 26        | of : 26           |  |
|                                                                                                                                  |  | S/N : IE24090_SE02                                    |                                                                                                     |                   |                   |                   |  |