



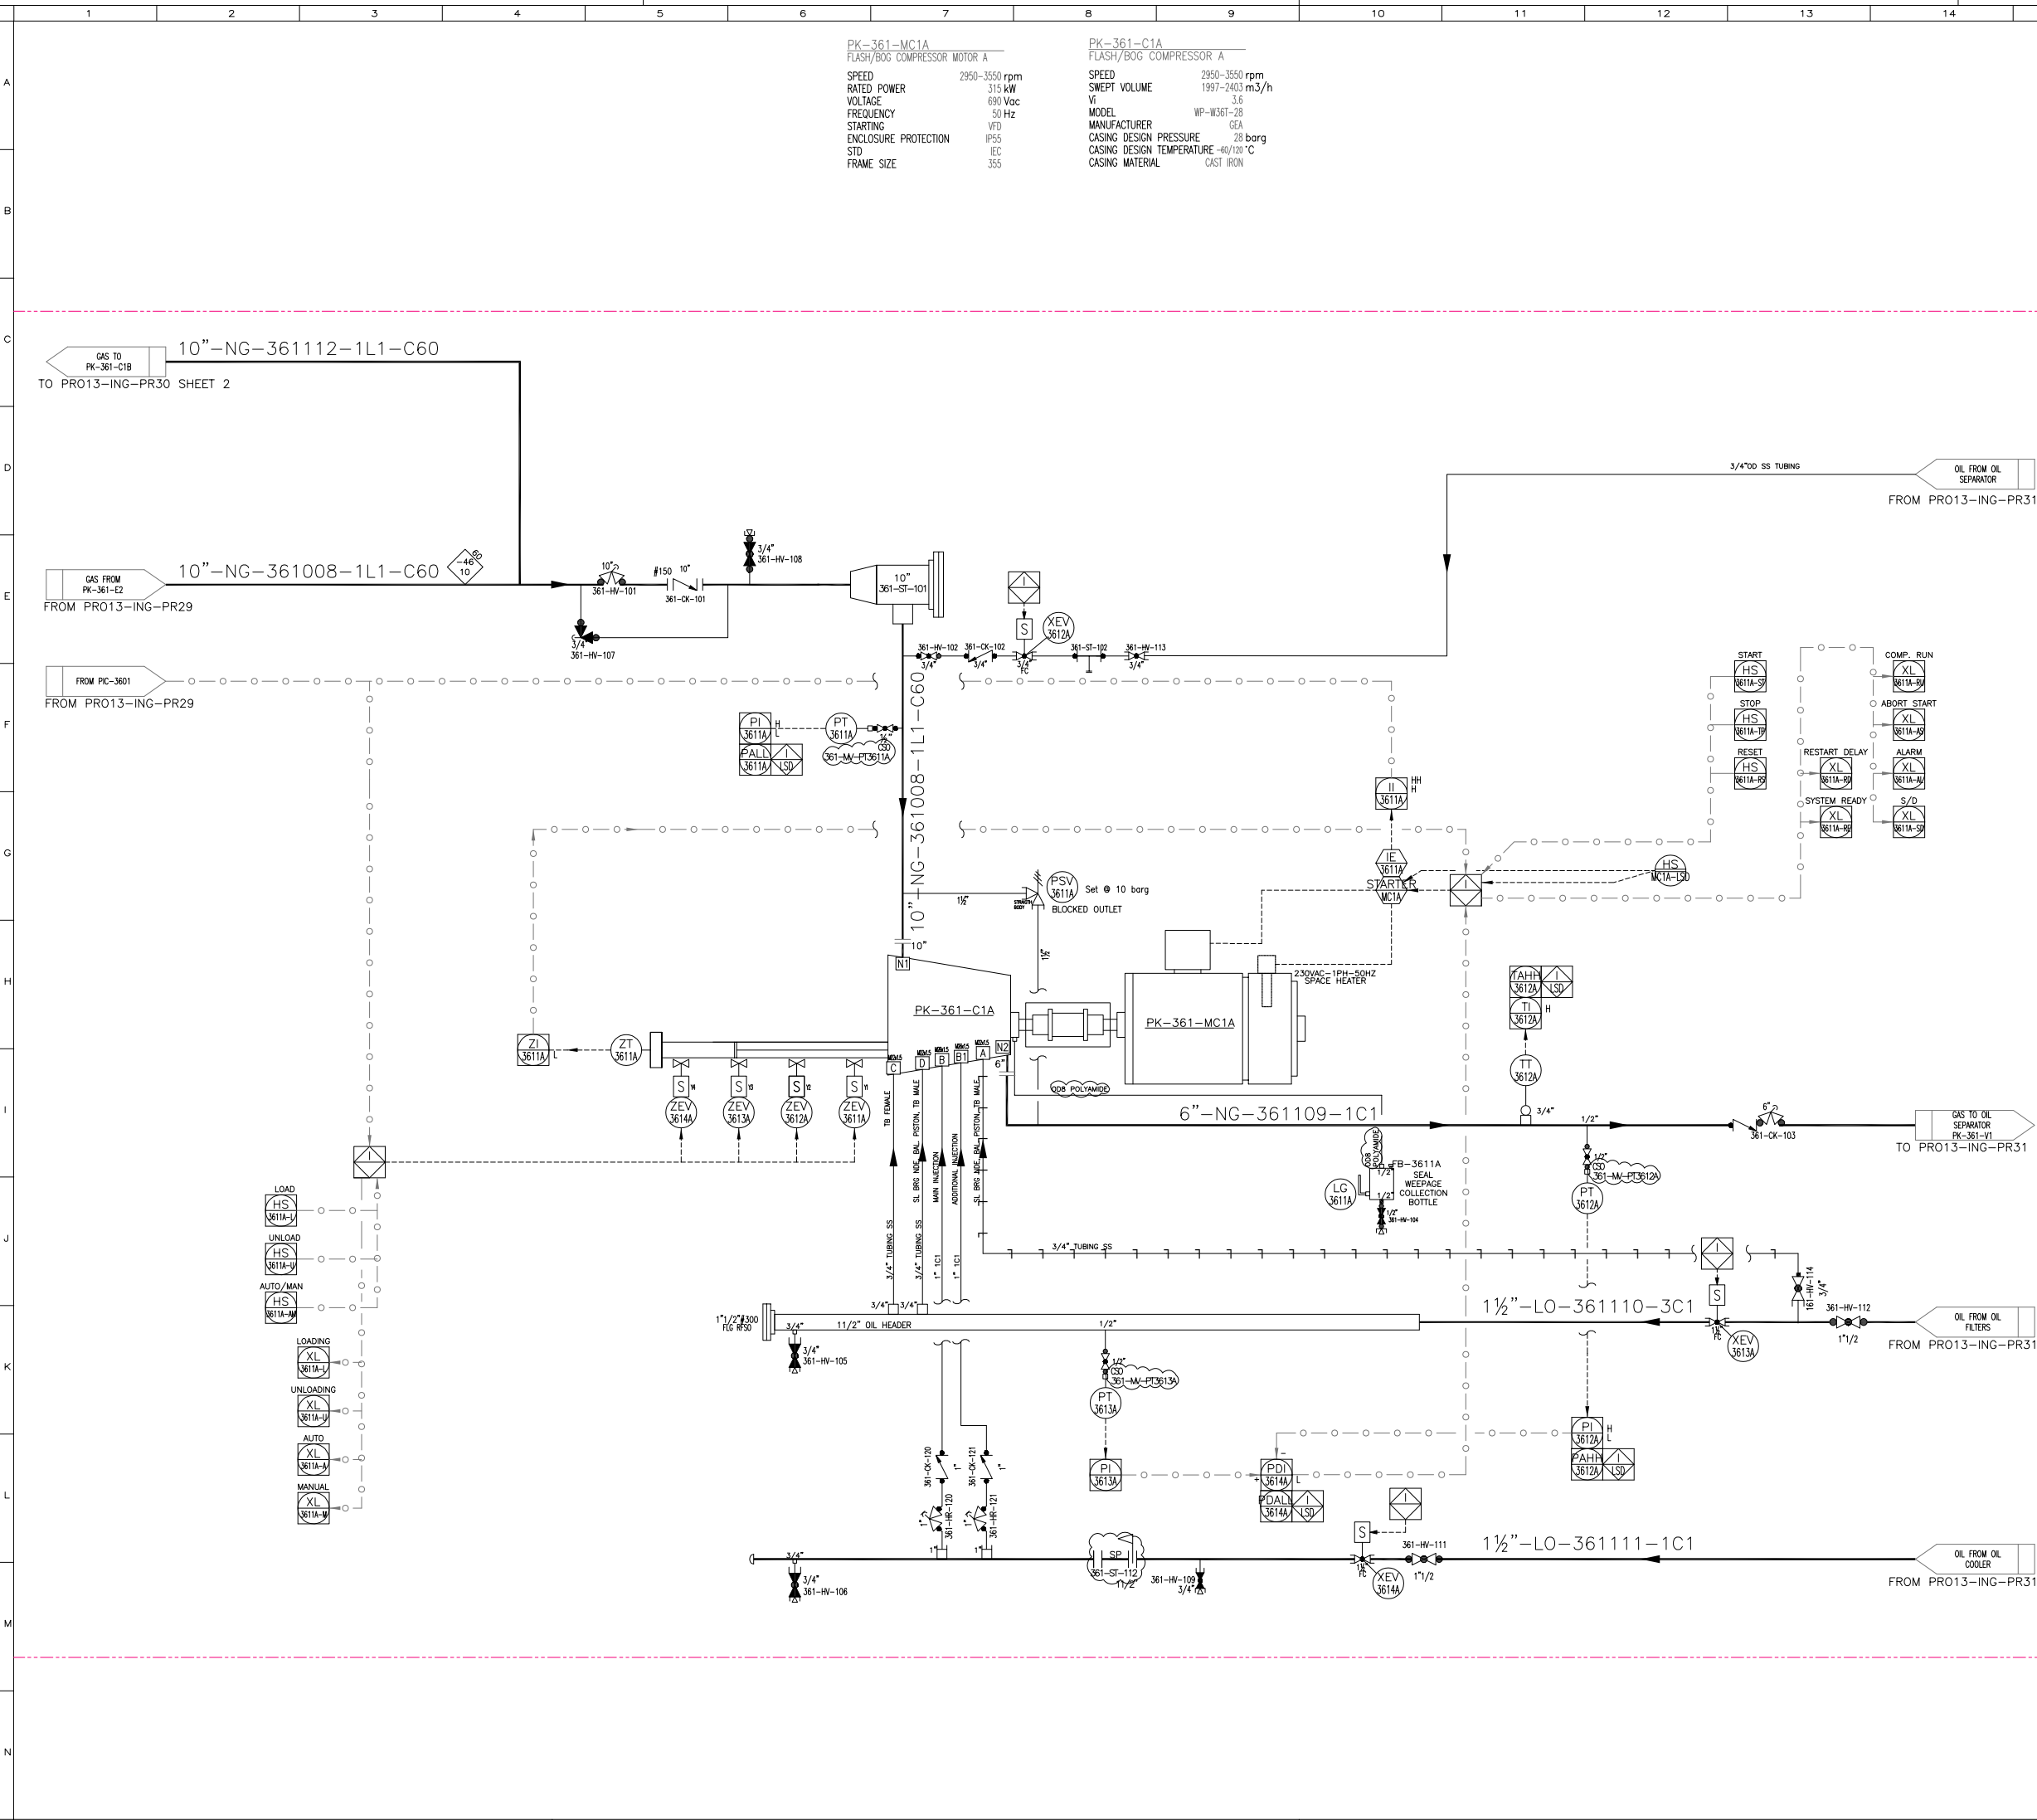

| REFERENCE DOCUMENTS          |                                               |                           |                                                                                                         |          |          |
|------------------------------|-----------------------------------------------|---------------------------|---------------------------------------------------------------------------------------------------------|----------|----------|
| P&ID LEGEND                  | PRO13-ING-PRO0<br>21044-PR-PID-00000          |                           |                                                                                                         |          |          |
| PROCESS FLOW DIAGRAM         | PRO10-ING-PRO1/02/03/04<br>21044-PR-PFD-00001 |                           |                                                                                                         |          |          |
| MATERIAL SELECTION DIAGRAM   | PRO08-ING-FR01<br>21044-PR-MSD-00001          |                           |                                                                                                         |          |          |
|                              |                                               |                           |                                                                                                         |          |          |
|                              |                                               |                           |                                                                                                         |          |          |
| NOTES:                       |                                               |                           |                                                                                                         |          |          |
|                              |                                               |                           |                                                                                                         |          |          |
|                              |                                               |                           |                                                                                                         |          |          |
| 5                            | 25 Mar 2026                                   | AS BUILT                  | TAM (JB)                                                                                                | TAM (MM) | L        |
| 4                            | 04 Apr 2025                                   | APPROVED FOR CONSTRUCTION | TAM (JB)                                                                                                | L        | COMPLONE |
| 3                            | 24 Jun 2024                                   | APPROVED FOR CONSTRUCTION | TAM (ES)                                                                                                | L        | COMPLONE |
| 2                            | 26 Jul 2023                                   | ISSUED FOR APPROVAL       | TAM (ES)                                                                                                | L        | COMPLONE |
| 1                            | 02 Nov 2022                                   | ISSUED FOR APPROVAL       | TAM (ES)                                                                                                | L        | COMPLONE |
| 0                            | 20 Jul 2022                                   | ISSUED FOR APPROVAL       | TAM (ES)                                                                                                | L        | COMPLONE |
| Rev.                         | Date                                          | Description               | Draft                                                                                                   | Check'd  | Approved |
| Customer:                    |                                               | MANAENERGY                | Offices:<br>Mahaj Riad Center, Batiment 6, 3eme etage,<br>Avenue Al Arz, Hay Ryad, 10100 Rabat, Morocco |          |          |
| Contractor:                  |                                               | ITALFLUID                 | Offices:<br>VIA VIVALDI,4 MONTESILVANO (ITALY)<br>Tel.+39 085 4224374 fax+39 085 4220742                |          |          |
| Engineering:                 |                                               | ITALFLUID                 | Offices:<br>VIA VIVALDI,4 MONTESILVANO (ITALY)<br>Tel.+39 085 4224374 fax+39 085 4220742                |          |          |
| technology Vendor:           |                                               | TECHNICAL AMERICA INC     | Offices:<br>301 N Smith Avenue, 92880 Corona, California (USA)<br>Ph.+1 951 272 9540                    |          |          |
| TITLE:<br>LNG TENDRARA PLANT |                                               |                           | OBJECT:<br>P&ID<br>SKID S-361 (UNIT 360)                                                                |          |          |
| TYPE                         | SCALE                                         | DOCUMENTS ID:             | VENDOR DOC. CODE                                                                                        |          | SHEET/OF |
| A1                           | N/A                                           | PRO13-ING-PR30            | 21044-PR-PID-36002                                                                                      |          | 1/2      |

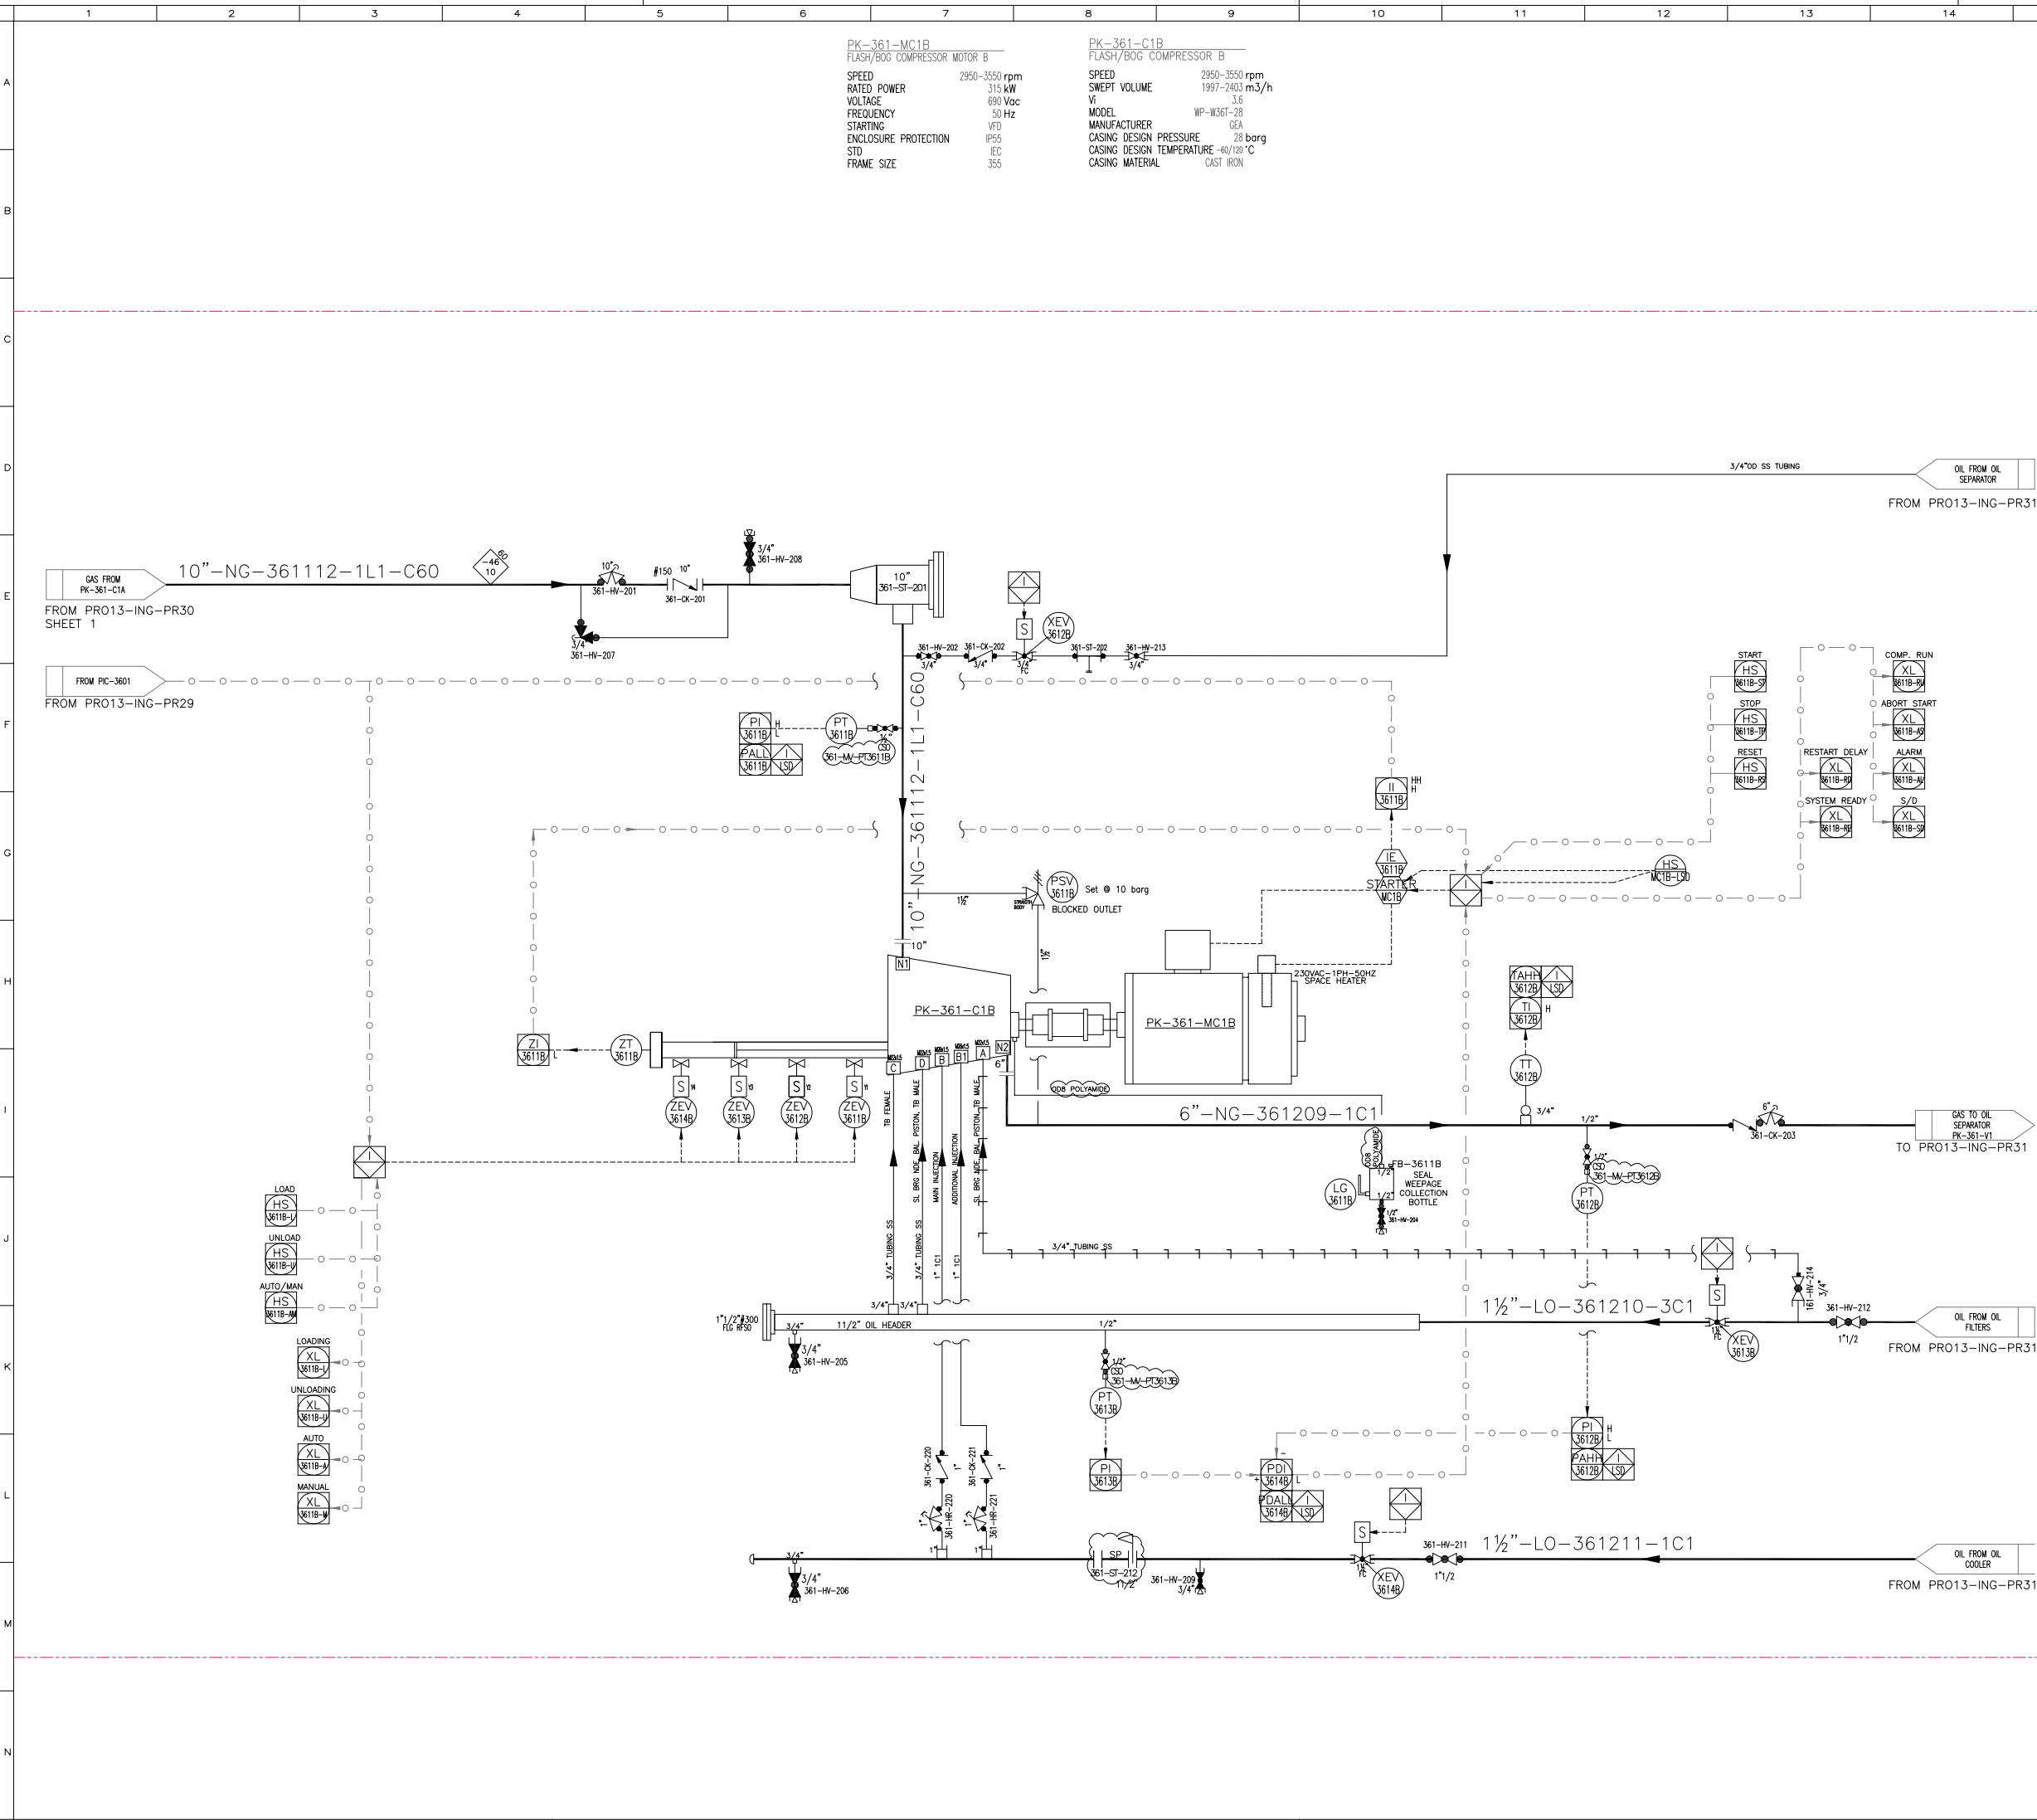

|                                          |             |                                                                                                   |                    |          |          |
|------------------------------------------|-------------|---------------------------------------------------------------------------------------------------|--------------------|----------|----------|
| 15                                       | 16          | 17                                                                                                | 18                 |          |          |
| REFERENCE DOCUMENTS                      |             |                                                                                                   |                    |          |          |
| P&ID LEGEND                              |             | PRO13-ING-PRO0                                                                                    |                    |          |          |
|                                          |             | 21044-PR-PID-00000                                                                                |                    |          |          |
| PROCESS FLOW DIAGRAM                     |             | PRO10-ING-PRO1/02/03/04                                                                           |                    |          |          |
|                                          |             | 21044-PR-PFD-00001                                                                                |                    |          |          |
| MATERIAL SELECTION DIAGRAM               |             | PRO08-ING-FR01                                                                                    |                    |          |          |
|                                          |             | 21044-PR-MSD-00001                                                                                |                    |          |          |
|                                          |             |                                                                                                   |                    |          |          |
|                                          |             |                                                                                                   |                    |          |          |
| NOTES:                                   |             |                                                                                                   |                    |          |          |
|                                          |             |                                                                                                   |                    |          |          |
|                                          |             |                                                                                                   |                    |          |          |
| ----- TAM SUPPLY LIMIT                   |             |                                                                                                   |                    |          |          |
|                                          |             |                                                                                                   |                    |          |          |
|                                          |             |                                                                                                   |                    |          |          |
| 5                                        | 25 Mar 2026 | AS BUILT                                                                                          | TAM (JB)           | TAM (MM) | L        |
| 4                                        | 04 Apr 2025 | APPROVED FOR CONSTRUCTION                                                                         | TAM (JB)           | L        | COMPLONE |
| 3                                        | 24 Jun 2024 | APPROVED FOR CONSTRUCTION                                                                         | TAM (ES)           | L        | COMPLONE |
| 2                                        | 26 Jul 2023 | ISSUED FOR APPROVAL                                                                               | TAM (ES)           | L        | COMPLONE |
| 1                                        | 02 Nov 2022 | ISSUED FOR APPROVAL                                                                               | TAM (ES)           | L        | COMPLONE |
| 0                                        | 20 Jul 2022 | ISSUED FOR APPROVAL                                                                               | TAM (ES)           | L        | COMPLONE |
| Rev.                                     | Date        | Description                                                                                       | Draft              | Check'd  | Approved |
| Customer: MANAENERGY                     |             | OFFICES: Mahaj Riad Center, Batiment 6, 3eme etage, Avenue Al Arz, Hay Ryad, 10100 Rabat, Morocco |                    |          | M        |
| Contractor: ITALFLUID                    |             | OFFICES: VIA VIVALDI,4 MONTESILVANO (ITALY) Tel.+39 085 4224374 fax+39 085 4220742                |                    |          |          |
| Engineering: ITALFLUID                   |             | OFFICES: VIA VIVALDI,4 MONTESILVANO (ITALY) Tel.+39 085 4224374 fax+39 085 4220742                |                    |          |          |
| technology Vendor: TECHNICAL AMERICA INC |             | OFFICES: 301 N Smith Avenue, 92880 Corona, California (USA) Ph.+1 951 272 9540                    |                    |          | N        |
| TITLE: LNG TENDRARA PLANT                |             | OBJECT: P&ID SKID S-361 (UNIT 360)                                                                |                    |          |          |
| TYPE                                     | SCALE       | DOCUMENTS ID:                                                                                     | VENDOR DOC. CODE   | SHEET/OF |          |
| A1                                       | N/A         | PRO13-ING-PR30                                                                                    | 21044-PR-PID-36002 | 2/2      |          |